


Labor and Material Report July 11 1928

no 39 Staple

37 or 39
?

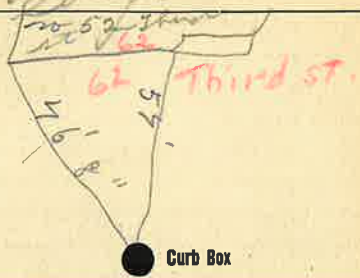

6" Main

Elev. of Main at tap 4'


Gate at ●

● Gate at

● Curb Box

Labor and Material Report Aug 24 1928

3/4 tap at 62 Third at

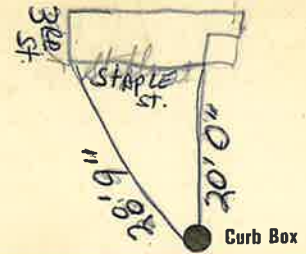

6" Main

Elev of Main at tap 4'

Gate at ●

● Gate at

3/4" copper 9' to main

● Curb Box

Walson Phil's

Tap on Staple St.

TAX ID# 309.11-11-12

Labor and Materials

1	Lead Connection	\$
1	Curb Cock	\$
1	Service Box { Short 3 $\frac{1}{2}$ x 4 $\frac{1}{2}$ Old returned } Long 4 $\frac{1}{2}$ x 5 $\frac{1}{2}$ Buffalo	\$
20	Ft. $\frac{3}{4}$ in. Galv. Pipe at	\$
	Nipples.....in. at	\$
	Bushings.....to.....in. at	\$
	Red'g Coup.....to.....in. at	\$
	Inc'g Coup.....to.....in. at	\$
	Union.....in. at	\$
	Meter.....in. at	\$
	Cu. Yds. Br. Stone at	\$
	Cu. Yds. Sand at	\$
	Bags Cement at	\$
	Paving Brick { Mack Red Asphalt } at	\$
	Hrs. Foreman at	\$
	Hrs. Common Labor at	\$
	Hrs. Mason at	\$
	Hrs.....at	\$
	Hrs.....at	\$
	Builders' Use of Water	\$
at	\$
at	\$
at	\$
at	\$
	Total	\$	

Labor and Materials

1	Copper } Connection $\frac{3}{4}$ " Lead	\$
1	Curb { Cock Valve } $\frac{3}{4}$ " in..... T. S. & V.	\$
1	Service Box { Short 3 $\frac{1}{2}$ x 4 $\frac{1}{2}$ Old returned } Long 4 $\frac{1}{2}$ x 5 $\frac{1}{2}$ Buff. or Rdway	\$
9	Ft. $\frac{3}{4}$ in. { Copper Galv. Iron } Pipe at..... Cast Iron	\$
	Nipples.....in. at	\$
	Bushings.....to.....in. at	\$
	Red'g } Couplings.....to.....in. at Inc'g }	\$
	Union.....in. at	\$
	Meter.....in. at	\$
	Lbs. Br. Stone at	\$
	Lbs. Sand at	\$
	Bags Cement at	\$
	Paving Brick { Mack Red Asphalt } at	\$
	Lead Joints at	\$
	Leadite Joints at	\$
	Hrs. Foreman at	\$
	Hrs. Common Labor at	\$
	Hrs. Common Labor at	\$
	Hrs. Mason at	\$
	Hrs. Mason's Helper at	\$
	Hrs. Compressor at	\$
	Compensation Ins	\$
	Trucking	\$
	Builders' Use of Water	\$

Total \$.....

Labor and Material Report July 11 1928

411 Staphle St



6" Main

Elev. of Main at tap 4'

Gate at ●

● Gate at

● Curb Box

Labor and Material Report July 11 1928

400 52 Third Street



6" Main

Elev. of Main at tap 4'

Gate at ●

● Gate at

● Curb Box

Labor and Materials

Lead Connection	\$
Curb Cock	\$
Service Box (Short 3½ x 4½)		
Old returned (Long 4½ x 5½)	\$
Buffalo		
50 Ft. 3/4 in. G. I. Pipe at	\$
Nipples in. at	\$
Bushings to..... in. at	\$
Red'g Coup to..... in. at	\$
Inc'g Coup to..... in. at	\$
Union in. at	\$
Meter in. at	\$
Cu. Yds. Br. Stone at	\$
Cu. Yds. Sand at	\$
Bags Cement at	\$
Paving Brick (Mack Red Asphalt) } at	\$
Hrs. Foreman at	\$
Hrs. Common Labor at	\$
Hrs. Mason at	\$
Hrs. at	\$
Hrs. at	\$
Hrs. at	\$
Builders' Use of Water	\$
..... at	\$
..... at	\$
..... at	\$
..... at	\$
Total	\$	

Labor and Materials

Lead Connection	\$
Curb Cock	\$
Service Box (Short 3½ x 4½)		
Old returned (Long 4½ x 5½)	\$
Buffalo		
7 Ft. 3/4 in. G. I. Pipe at	\$
Nipples in. at	\$
Bushings to..... in. at	\$
Red'g Coup to..... in. at	\$
Inc'g Coup to..... in. at	\$
Union in. at	\$
Meter in. at	\$
Cu. Yds. Br. Stone at	\$
Cu. Yds. Sand at	\$
Bags Cement at	\$
Paving Brick (Mack Red Asphalt) } at	\$
Hrs. Foreman at	\$
Hrs. Common Labor at	\$
Hrs. Mason at	\$
Hrs. at	\$
Hrs. at	\$
Hrs. at	\$
Builders' Use of Water	\$
..... at	\$
..... at	\$
..... at	\$
..... at	\$
Total	\$	