

1946

St. Lot #18


Third

Pl. Ave. No. 67

Name of Owner

Tball

Labor and Mat'l. Report April 16 1946

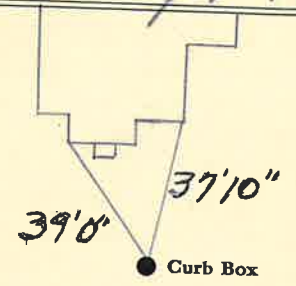

6" Main

Elev. of Main at tap 5

Gate at ●

● Gate at

3/4" copper

9' to main

● Curb Box

New House


Third

St. Pl.

Ave. No. 67

Name of Owner

Labor and Mat'l. Report 5/2008

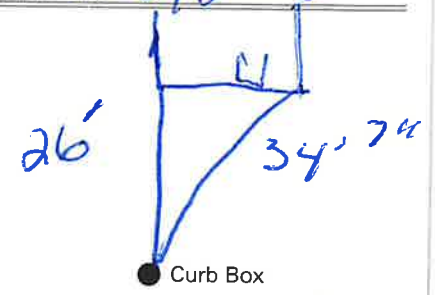

Main

Elev. of Main at tap

Gate at ●

● Gate at

TAX ID # 309.11-5-60

● Curb Box

