

LABOR AND MATERIALS

1 Copper	Connection	3/4			\$ 1.31	
1	Curb	{ Cock Valve T. S. & V. }	3/4	in.	\$ 1.75	
						\$ 1.60
1	Service Box Old returned	{ Short 3/2x4 1/2 Long 4 1/2x5 1/2 Buff. or Rdway }				\$ 1.80
			} Pipe at 18			
10 Ft. 3/4 in.		{ Copper Galv Iron Cast Iron }				
Nipples		in. at		\$		
Bushings		to in. at		\$		
Red'g Inc'g	} Couplings	to in. at		\$		
				\$		
Union		in. at		\$		
Meter		in. at		\$		
Lead Joints at				\$		
Leadite Joints at				\$		
Hrs. Foreman at				\$		
2	Hrs. Chauffeur at		6 2 1/2		\$ 1.25	
4	Hrs. Tapper at		"		\$ 2.50	
4	Hrs. Labor at		45		\$ 1.80	
Hrs. Labor at				\$		
Hrs. Compressor at				\$		
Compensation Ins.				\$		
Trucking				\$ 1.17		
Builders Use of Water		no patch		\$		
Top by Hassel				\$		
				\$		
				\$		
				\$ 13.18		

08 - 1940

St.

Third

FF


Ave. No. 71

Name of Owner

Alkes

Labor and Mat'l. Report

Sept 12 1940

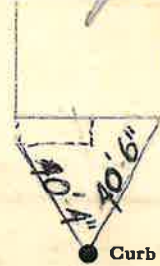

● Curb Box

6 Main

Elev. of Main at tap 4'

Gate at ●

● Gate at

3/4" Copper 10' to main

● Curb Box

TAX ID # 309.11-5-58

New