

3 4 - - 1940

Third


St. Ave. No. 73

Name of Owner

Ball

Labor and Mat'l. Report

July 3 1940

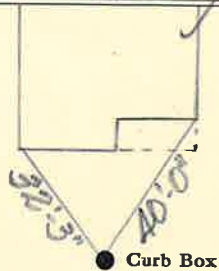

6 Main

Elev. of Main at tap 5

Gate at

Gate at

3/4" COPPER

9' to main

Curb Box

TAX ID# 309.11-5-57


OUTSIDE ~~St. LEAN~~ OUT
Pl. Ave. No. 001

Name of Owner

73 Third ST

Labor and Mat'l. Report

11/30/18

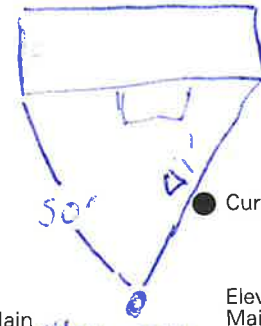

Main

Elev. of Main at tap

Gate at

Gate at

Right side of water

Curb Box

LABOR AND MATERIALS

1 Copper } Connection 3/4 \$ 1.31
 Lead }

1 Curb { Cock Valve } 3/4 in. \$ 1.75
 T.S. & V. }

1 Service Box { Short 3 1/2 x 4 1/2 }
 Old returned { Long 4 1/2 x 5 1/2 } \$ 1.60
 Buff. or Rdway }

9 Ft. 3/4 in. { Copper } Pipe at 18 \$ 1.62
 Galv. Iron }
 Cast Iron }

Nipples in. at \$
 Bushings to in. at \$
 Red'g } Couplings to in. at \$
 Inc'g }

Union in. at \$
 Meter in. at \$
 Lead Joints at \$
 Leadite Joints at \$
 Hrs. Foreman at \$
 Hrs. Chauffeur at \$
 Hrs. Tapper at \$
 4 Hrs. Labor at 45 \$ 1.80
 Hrs. Labor at \$
 Hrs. Compressor at \$
 Compensation Ins. \$.06
 Trucking \$ 1.00
 Builders Use of Water no patch \$
 545-

\$ 9.14

LABOR AND MATERIALS

Copper } Connection \$
 Lead }

Curb { Cock Valve } in. \$
 T.S. & V. }

Service box { Short 3-1/2 x 4-1/2 } \$
 Old returned { Long 4-1/2 x 5-1/2 }

Ft. in. { Copper } Pipe at \$
 G.I. }
 C.I. }

Nipples in. at \$
 Bushings to in. at \$
 Red'g
 Inc'g
 Union in. at \$
 Meter in. at \$
 \$
 Compound Joints at \$
 Maintenance Foreman \$
 Hrs. Water Maint. Man- 1 at \$
 Hrs. Water Maint. Man - 2 at \$
 Hrs. Garage Foreman at \$
 Hrs. Labor at \$
 Hrs. Compressor at \$
 \$
 Trucking \$
 Pav't Patch \$
 \$
 \$
AIR