

LABOR AND MATERIALS


1	Copper	Connection	3/4"	\$
1	Lead	Cock	3/4" Oriseal	\$
1	Curb	Valve	3/4" in.	\$
		T.S. & V.		
1	Service box	Short 3 1/2 x 4 1/2		
	Old returned	Long 4 1/2 x 5 1/2		
		Buff or Rdway		\$
26	Ft.	Copper	Pipe at	\$
		G.I.		
		G.I.		
	Nipples	in. at		\$
	Bushings	to in. at		\$
	Red'g			
	Inc'g	Coupl'gs to in. at		\$
	Union	in. at		\$
	Meter	in. at		\$
	Lead Joints	at		\$
	Compound Joints	at		\$
	Maintenance Foreman			\$
	Hrs. Water Maint. Man-1	at		\$
	Hrs. Water Maint. Man-2	at		\$
	Hrs. Garage Foreman	at		\$
	Hrs. Labor	at		\$
	Hrs. Compressor	at		\$
	Compensation Ins. at \$	per C		\$
	Trucking			\$
	Pav't Patch			\$
	Tap by Gifford & Co.			\$
	5-6-68			\$
	O'head			\$

74?

Third St. Pl. Ave. No. 72

Name of Owner Robert

Labor and Mat'l. Report May 6 1968

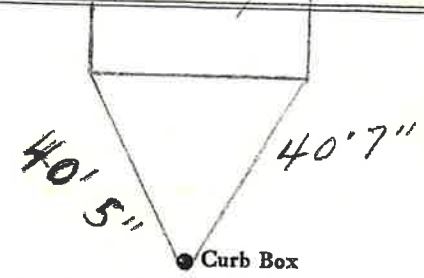

6" Main Elev. of Main at tap 5'

Gate at • Gate at

3/4" COPPER 26' to MAIN

#74

TAX ID # 309.11-10-7