


LABOR AND MATERIALS

1	Copper	Connection	3/4"	\$
1	Lead	Cock	3/4 in.	\$
1	Curb	Valve		\$
		T. S. & V.		\$
1	Service box	Short 3 1/2 x 4 1/2		\$
	Old returned	Long 4 1/2 x 5 1/2		\$
		Buff. or Rdway		\$
24	Ft. 3/4 in.	Copper	Pipe at	\$
		C.I.		\$
		C.I.		\$
	Nipples	in. at		\$
	Bushings	to in. at		\$
	Red'g			\$
	Inc'g	Coupl'gs. to in. at		\$
	Union	in. at		\$
	Meter	in. at		\$
	Lead Joints	at		\$
	Compound Joints	at		\$
	Maintenance Foreman			\$
	Hrs. Water Maint. Man-1	at		\$
	Hrs. Water Maint. Man-2	at		\$
	Hrs. Garage Foreman	at		\$
	Hrs. Labor	at		\$
	Hrs. Compressor	at		\$
	Compensation Ins.	at \$ per C		\$
	Trucking			\$
	Pav't Patch			\$
	Tap by Gifford & Co.			\$
	7-2-65			\$
	O'head			\$
				\$

St. Third
 Ave. No. 78

Name of Owner
Anna Leahy

Labor and Mat'l. Report July 2 1965

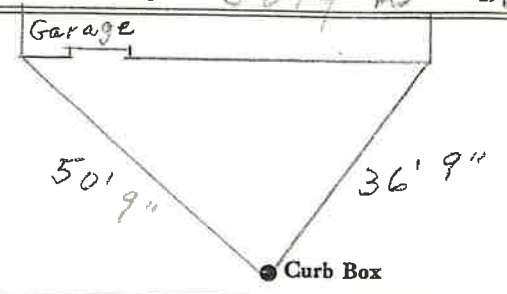

6 C.I. Main Elev. of Main at tap 5

Gate at • • Gate at

3/4" Copper 24' to main

• Curb Box

TAX ID # 309.11-10-8