


LABOR AND MATERIALS

| | | | | |
|--------|-------------------------|--|-----------|----|
| 1 | Copper Lead | Connection | 3/4" | \$ |
| 1 | Curb | Cock Valve T.S. & V. | 3/4 in. | \$ |
| 1 | Service box | Short 3 1/2 x 4 1/2 Long 4 1/2 x 5 1/2 Buff or Rdway | | \$ |
| | Old returned | | | \$ |
| 26 Ft. | 3/4 in. | Copper G.I. C.I. | Pipe at | \$ |
| | Nipples | in. at | | \$ |
| | Bushings | to in. at | | \$ |
| | Red'g Inc'g | Coupl'gs | to in. at | \$ |
| | Union | in. at | | \$ |
| | Meter | in. at | | \$ |
| | Lead Joints | at | | \$ |
| | Compound Joints | at | | \$ |
| | Maintenance Foreman | | | \$ |
| | Hrs. Water Maint. Man-1 | at | | \$ |
| | Hrs. Water Maint. Man-2 | at | | \$ |
| | Hrs. Garage Foreman | at | | \$ |
| | Hrs. Labor | at | | \$ |
| | Hrs. Compressor | at | | \$ |
| | Compensation Ins. | at \$ per C. | | \$ |
| | Trucking | | | \$ |
| | Pav't Patch | | | \$ |
| | Tap by Giggord & Co. | | | \$ |
| | 11-12-63. | | | \$ |
| | O'head | | | \$ |

St. Third
 Pt. 80
 Ave. No. 80

Name of Owner Milton Bell

Labor and Mat'l. Report Nov. 12 1963

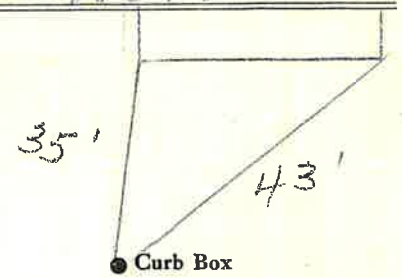

6" C.I. Main
 Elev. of Main at tap 5 1/2'

Gate at ● Gate at ●

3/4" Copper 26' to main
 ● Curb Box

TAX ID # 309.11-10-9