

79

Third St


St. Pl. Ave. No. 83

Name of Owner

Sweet

Labor and Mat'l. Report

Nov 10 1948

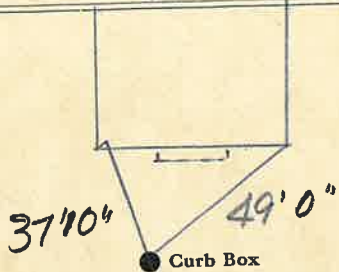

6" Main

Elev. of Main at tap

Gate at ●

● Gate at

3/4" Copper

8' to main

● Curb Box


Third

St. Pl. Ave. No. 83

Name of Owner

Labor and Mat'l. Report

Nov 19 88

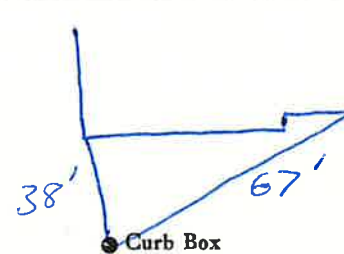

Elev. of Main at tap

Gate at ●

● Gate at

3/4" Copper

10' to main

● Curb Box

TAX ID# 309.11-5-53

