

LABOR AND MATERIALS

Copper	Connection	3/4		\$ 294
Lead				
Curb	Cock Valve	3/4	in.	\$ 2.71
	T. S. & V.			
Service box	Short 3/4 X 4 1/2			
Old returned	Long 4 1/2 X 5 1/2			\$ 5.90
	Buffer Rdway			
5 Ft.	Copper		Pipe at 30	\$ 2.40
	G. I.			
	C. I.			
Nipples	in. at			\$
Bushings	to in. at			\$
Red'g				
Inc'g	Coupl'gs to in. at			\$
Union	in. at			\$
Meter	in. at			\$
Lead Joints	at			\$
Compound Joints	at			\$
1 Hrs. Water Maint. Man-1	at			\$ 1.12
1 Hrs. Water Maint. Man-2	at			\$ 1.02
3 Hrs. Labor	at			\$ 2.73
Hrs. Labor	at			\$
Hrs. Compressor	at			\$
Compensation Ins.	at \$ per C.			\$ 1.11
Trucking				\$ 1.11
Pav't Patch				\$
				\$
				\$
O'head				\$
				\$ 20.93

80.

St.
Pl.
Ave. No. 85


third

Name of Owner

Sweet

Labor and Mat'l. Report

MAR 10 19 21

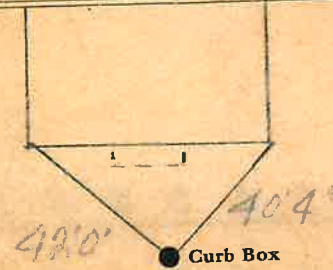

6 Main Elev. of Main at tap 8

Gate at ● ● Gate at

3/4" Copper 8' to MAIN

● Curb Box

TAX ID # 309.11-5-52