

160

Third


St. ⁸⁶
Pl. ⁸⁸
Ave. No. ⁸⁸

Name of Owner

Sweet

Labor and Mat'l. Report

Nov 19 1948

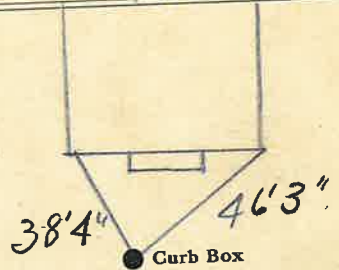

6 Main

Elev. of Main at tap 7

Gate at ●

● Gate at

3/4" copper 25' to MAIN

● Curb Box

LSM-5C B 15-48

This top in center house

Third


St. ⁸⁶
Pl. ⁸⁶
Ave. No. ⁸⁶

Name of Owner

George Delano

Labor and Mat'l. Report

Nov. 6 1958

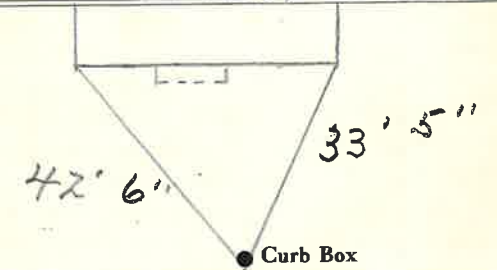

6" Main

Elev. of Main at tap 7'

Gate at ●

● Gate at

3/4" copper 28' to MAIN

● Curb Box

TAX ID # 309.11-9-2

LSM-5C-2.5 56

LABOR AND MATERIALS

1	Copper Lead	Connection	3/4	\$	2.94
1	Curb	Cock Valve	3/4 in.	\$	3.71
1	Service box	Short 3 1/2 X 4 1/2		\$	5.90
	Old returned	Long 4 1/2 X 5 1/2		\$	
		Buff or Rdway		\$	
25	Ft. 3/4 in.	Copper Pipe at	30	\$	7.50
		G. I.		\$	
		C. I.		\$	
	Nipples	in. at		\$	
	Bushings	to in. at		\$	
	Red'g			\$	
	Inc'g	Coupl'gs to in. at		\$	
	Union	in. at		\$	
	Meter	in. at		\$	
	Lead Joints	at		\$	
	Compound Joints	at		\$	
1/2	Hrs. Water Maint. Man-1	at	1.12	\$	56
6	Hrs. Water Maint. Man-2	at	1.02	\$	6.12
17	Hrs. Labor-	at		\$	15.47
	Hrs. Labor-	at		\$	
	Hrs. Compressor at			\$	
	Compensation Ins. at	\$ 2.20 per C.		\$	
	Trucking			\$	1.49
	Pav't Patch			\$	
	Tap by			\$	
	O'head			\$	
				\$	43.69

LABOR AND MATERIALS

1	Copper Lead	Connection	3/4	\$	
1	Curb	Cock Valve	3/4 in.	\$	
1	Service box	Short 3 1/2 x 4 1/2		\$	
	Old returned	Long 4 1/2 x 5 1/2		\$	
		Buff or Rdway		\$	
28	Ft. 3/4 in.	Copper Pipe at		\$	
		G. I.		\$	
		C. I.		\$	
	Nipples	in. at		\$	
	Bushings	to in. at		\$	
	Red'g			\$	
	Inc'g	Coupl'gs to in. at		\$	
	Union	in. at		\$	
	Meter	in. at		\$	
	Lead Joints	at		\$	
	Compound Joints	at		\$	
	Maintenance Foreman			\$	
	Hrs. Water Maint. Man-1	at		\$	
	Hrs. Water Maint. Man-2	at		\$	
	Hrs. Garage Foreman	at		\$	
	Hrs. Labor-	at		\$	
	Hrs. Compressor at			\$	
	Compensation Ins. at	\$ per C.		\$	
	Trucking			\$	
	Pav't Patch			\$	
	Tap by	Gifford & Co.		\$	
		11-6-58.		\$	
	O'head			\$	
				\$	