

LABOR AND MATERIALS

| | | | | | |
|---|-------------------------|--------------------|-----|-----|----------|
| 1 | Copper | Connection | 3/4 | | \$ 2.94 |
| 1 | Lead | Cock | 3/4 | in. | \$ 3.71 |
| | | Valve | | | |
| | | T. S. & V. | | | |
| 1 | Service box | Short 3/2 X 4 1/2 | | | \$ 5.90 |
| | Old returned | Long 4 1/2 X 5 1/2 | | | |
| | | Buff or Rdway | | | |
| 8 | Ft. | Copper | 3/4 | in. | |
| | | G. I. | | | |
| | | C. I. | | | |
| | | Pipe at | 30 | | \$ 2.40 |
| | Nipples | in. at | | | \$ |
| | Bushings | to in. at | | | \$ |
| | Red'g | | | | \$ |
| | Inc'g | Coupl'gs to in. at | | | \$ |
| | Union | in. at | | | \$ |
| | Meter | in. at | | | \$ |
| | Lead Joints | at | | | \$ |
| | Compound Joints | at | | | \$ |
| 4 | Hrs. Water Maint. Man-1 | at | | | \$ 4.08 |
| 4 | Hrs. Water Maint. Man-2 | at | 107 | | \$ 3.64 |
| 4 | Hrs. Labor | at | 91 | | \$ 1.17 |
| | Hrs. Labor | at | | | \$ |
| | Hrs. Compressor | at | | | \$ |
| | Compensation Ins. | at \$ 2.20 per C | | | \$ |
| | Trucking | | | | \$ |
| | Pav't Patch | | | | \$ |
| | Top 4 M. S. Union | | | | \$ |
| | O'head | | | | \$ 23.84 |

82


Third St

St. _____
Pl. _____
Ave. No. 89

Name of Owner

Sweet

Labor and Mat'l. Report Nov 10 1948

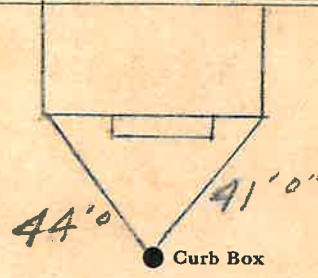

6 Main Elev. of Main at tap 8

Gate at ● Gate at ●

3/4" Copper 8' to main

● Curb Box

TAX ID# 309.11-5-50

This top is center of house

LSM-5C 5 15-48