


LABOR AND MATERIALS

1	Copper	} Connection $\frac{3}{4}$ "	\$
	Lead		
1	Curb	} Valve $\frac{3}{4}$ in.	\$
			T. S. & V.
1	Service box	} { Short $3\frac{1}{2}$ x $4\frac{1}{2}$ Long $4\frac{1}{2}$ x $5\frac{1}{2}$ Buff or Rdway	\$
	Old returned		
12	Ft. $\frac{3}{4}$ in.	} { Copper G.I. G.I.	Pipe at \$
	Nipples	in. at	\$
	Bushings	to in. at	\$
	Red'g	} Coupl'gs to in. at	\$
	Inc'g		
	Union	in. at	\$
	Meter	in. at	\$
	Lead Joints at		\$
	Compound Joints at		\$
	Maintenance Foreman		\$
	Hrs. Water Maint. Man	1 at	\$
	Hrs. Water Maint. Man	2 at	\$
	Hrs. Garage Foreman	at	\$
	Hrs. Labor	at	\$
	Hrs. Compressor at		\$
	Compensation Ins. at \$	per C	\$
	Trucking		\$
	Pav't Patch		\$
	Tap by Moguinn		\$
	May 18-1949		\$
	O'head		\$

Third St. Ave. No. 91

Name of Owner Sweet

Labor and Mat'l. Report May 18 1949

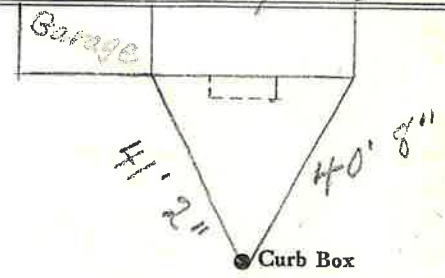

6" Main Elev. of Main at tap 7

Gate at • Gate at

$\frac{3}{4}$ " COPPER 12' to MAIN

• Curb Box

TAX ID # 309.11-5-49