


3rd

St. Pl. Ave. No. 92

Name of Owner

Labor and Mat'l. Report 1948

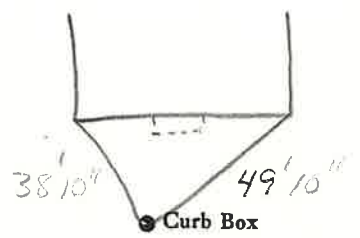

6" Main Elev. of Main at tap 6'

Gate at • Gate at •

3/4" Copper


• Curb Box

THIRD

St. Pl. Ave. No. 92

Name of Owner TAX ID# 309.11-9-4

Labor and Mat'l. Report 19

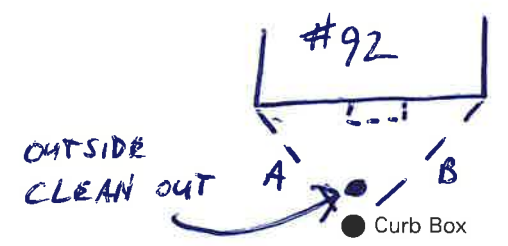

6" Main Elev. of Main at tap 6'

Gate at • Gate at •

3/4" COPPER

• Curb Box

A = 34' ~~10'~~

B = 46' ~~10'~~

OUTSIDE CLEAN OUT LOCATED 3' BEHIND CURB BOX

