

35 - 47

St.
Pl.
Ave. No. 95

Third

Name of Owner

Sweet

Labor and Mat'l. Report

May 18 1947

43'9"

40'9"

Hyp. 380'5"

Curb Box

6 Main

Elev. of Main at tap 6

Gate at ●

● Gate at

3/4" copper 12' to main

● Curb Box

THIRD


St. Pl. Ave. No. 95

Name of Owner

TAX ID # 309.11-5-48

Labor and Mat'l. Report To

8/14/2012

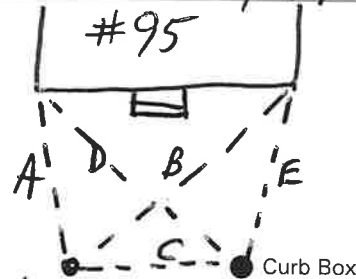

CLEAN OUT

6 Main

Elev. of Main at tap 6

Gate at ●

● Gate at

12' OF 3/4" COPPER TO MAIN

● Curb Box

A = 38'

B = 47'

C = 16'

D = 43'9"

E = 40'9"

