

LABOR AND MATERIALS

Copper Connection	3/4	\$ 2.87
Lead		
Curb Cock	3/4 in.	\$ 3.62
Valve		
T. S. & V.		
Service box	Short 3 1/2 X 4 1/2	\$ 4.68
Old returned	Long 4 1/2 X 5 1/2	
	Buff or Rdway	
12 Ft. 3/4 in. Copper Pipe at	32	\$ 3.84
	G. I.	
	C. I.	
Nipples	in. at	\$
Bushings	to in. at	\$
Red'g		
Inc'g	Coupl'gs. to in. at	\$
Union	in. at	\$
Meter	in. at	\$
Lead Joints at		\$
Compound Joints at		\$
Hrs. Water Maint. Man—1 at		\$
Hrs. Water Maint. Man—2 at		\$ 1.02
4 Hrs. Labor— at	91	\$ 3.64
Hrs. Labor— at		\$
Hrs. Compressor at		\$
Compensation Ins. at \$	per C	\$ 10
Trucking		\$ 2
Pav't Patch		\$
Top by Hyman		\$
O'head		\$ 21.77

37

St.
Pl.
Ave. No. 97


Third

Name of Owner

~~Sweet~~ Pandellin

Labor and Mat'l. Report

17 May 18 1949

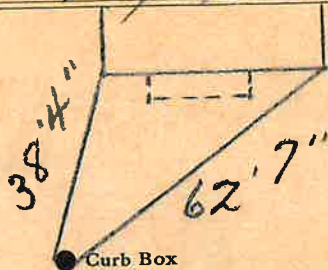

6

Elev. of Main at top 6

Gate at ●

● Gate at

7 1/4" Copper

12' to main

● Curb Box