

### Labor and Materials

.....Copper } Connection..... <sup>3/4</sup> .....	\$ 1.25
.....Lead } .....	
.....Curb { Cock Valve } .. <sup>3/4</sup> in .....	\$ 1.70
.....P.S.&V. } .....	
.....Service Box { Short 3 1/2 x 4 1/2 } .....	\$ 1.37
.....Old returned { Long 4 1/2 x 5 1/2 } .....	
.....Buff. or Flange } .....	
.....10 Ft. <sup>3/4</sup> in. { Copper } Pipe at 13 1/2 .....	\$ 1.25
.....Galv. Iron } .....	
.....Cast Iron } .....	
.....Nipples ..... in. at .....	\$ .....
.....Bushings ..... to ..... in. at .....	\$ .....
.....Red'g } Couplings..... to ..... in. at .....	\$ .....
.....Inc'g } .....	
.....Union..... in. at .....	\$ .....
.....Meter..... in. at .....	\$ .....
.....Lbs. Br. Stone at .....	\$ .....
.....Lbs. Sand at .....	\$ .....
.....Bags Cement at .....	\$ .....
.....Paving Brick { Mack } at .....	\$ .....
.....Red } .....	
.....Asphalt } .....	
.....Lead Joints at .....	\$ .....
.....Leadite Joints at .....	\$ .....
.....4 Hrs. Foreman at ..... <sup>42hr</sup> .....	\$ 2.52
.....16 Hrs. Common Labor at <sup>45</sup> .....	\$ 7.20
.....Hrs. Common Labor at .....	\$ .....
.....Hrs. Mason at .....	\$ .....
.....Hrs. Masons Helper at .....	\$ .....
.....Hrs. Compressor at .....	\$ .....
.....Compensation Ins .....	\$ 37
.....Trucking .....	\$ 1.-
.....Builders Use of Water ..Patch.....	\$ 5.-
Total \$ 21.74	


1935-83

Labor and Material Report

19

July 24 30

12 1/2" ~~at~~

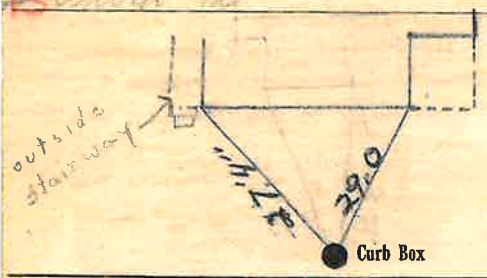

6" Main Elev of Main at tap 4 1/2

Gate at <sup>●</sup> 3/4" copper 10' to MAIN ● Gate at

● Curb Box

*Old tap shut off at main*

TAX ID # 309.12-10-37

*5/16*