

LABOR AND MATERIALS

Copper	Lead	Connection	3/4		\$ 2.87
1	Curb	Valve	3/4	in.	\$ 3.62
		T. S. & V.			
1	Service box	Short 3/2 X 4 1/2			
	Old returned	Long 4 1/2 X 5 1/2			\$ 4.68
		Buff or Rdway			
25	Ft.	3/4 in.		Pipe at	37 \$ 8.00
		Copper			
		G. I.			
		C. I.			
	Nipples	in.		at	\$
	Bushings	to		in. at	\$
	Red'g				
	Inc'g	Coupl'gs		to in. at	\$
	Union	in.		at	\$
	Meter	in.		at	\$
	Lead Joints			at	\$
	Compound Joints			at	\$
	Hrs. Water Maint. Man-1			at	\$
	Hrs. Water Maint. Man-2			at 1.02	\$
	Hrs. Labor			at	\$
3	Hrs. Labor			at 9.1	\$ 2.73
	Hrs. Compressor			at	\$
	Compensation Ins.			at \$ 2.18 per C	\$.06
	Trucking				\$ 2.-
	Pav't Patch				\$
	Tap by Maguire				\$
	O'head				\$
					\$ 23.96


32

St. 102
Pr.
Ave. No. 92

Third

Name of Owner
Sweet

Labor and Mat'l. Report May 18 1949

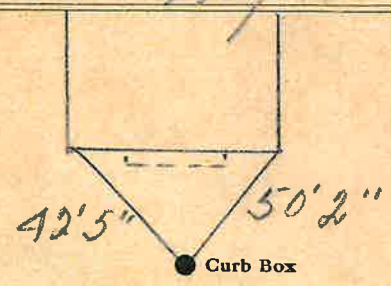

6" Main Elev. of Main at tap 6

Gate at ● ● Gate at

3/4" copper 25' to main

● Curb Box

TAX ID # 309.11-9-8