


LABOR AND MATERIALS

Copper	} Connection	_____	\$ _____	
Lead				
Curb	} Cock	_____ in.	\$ _____	
				} Valve
Service box	} Short 3 1/2 x 4 1/2	_____	\$ _____	
				} Long 4 1/2 x 5 1/2
Old returned				
Ft. <u>3/4</u> in.	} Copper	} Pipe at _____	\$ _____	
				} G.I.
Nipples	_____ in. at _____	\$ _____		
Bushings	_____ to _____ in. at _____	\$ _____		
Red'g	} Coupl'gs	_____ to _____ in. at _____	\$ _____	
Inc'g				
Union	_____ in. at _____	\$ _____		
Meter	_____ in. at _____	\$ _____		
_____			\$ _____	
Compound Joints	_____ at _____	\$ _____		
Maintenance Foreman	_____ at _____	\$ _____		
Hrs. Water Maint. Man—1	_____ at _____	\$ _____		
Hrs. Water Maint. Man—2	_____ at _____	\$ _____		
Hrs. Garage Foreman	_____ at _____	\$ _____		
Hrs. Labor—	_____ at _____	\$ _____		
Hrs. Compressor	_____ at _____	\$ _____		
_____			\$ _____	
Trucking	_____ at _____	\$ _____		
Pav't Patch	_____ at _____	\$ _____		
_____			\$ _____	
_____			\$ _____	
_____			\$ _____	
_____			\$ _____	

St. THIRD  
 -Pl: \_\_\_\_\_  
 Ave. No. 103

Name of Owner \_\_\_\_\_  
TAX ID # 309.11-5-40

Labor and Mat'l. Report \_\_\_\_\_ 1994

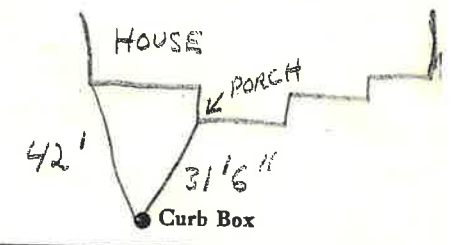

6" Main \_\_\_\_\_ Elev. of Main at tap \_\_\_\_\_

Gate at • \_\_\_\_\_ • Gate at \_\_\_\_\_

3/4" Copper

• Curb Box