


LABOR AND MATERIALS

Copper	} Connection	_____	\$ _____	
Lead				
Curb	} Cock } Valve } T. S. & V.	_____ in.	\$ _____	
Service box		} Short 3 1/2 x 4 1/2 } Long 4 1/2 x 5 1/2		
Old returned				\$ _____
26'6" Ft.	} Copper } C.I. } C.I.	3/4 in.	Pipe at \$ _____	
Nipples		_____ in.	at \$ _____	
Bushings	_____ to _____ in.	at \$ _____		
Red'g } Inc'g }	} Coupl'gs	_____ to _____ in.	at \$ _____	
Union		_____ in.	at \$ _____	
Meter	_____ in.	at \$ _____		
Compound Joints	at \$ _____			
Maintenance Foreman	\$ _____			
Hrs. Water Maint. Man-1	at \$ _____			
Hrs. Water Maint. Man-2	at \$ _____			
Hrs. Garage Foreman	at \$ _____			
Hrs. Labor	at \$ _____			
Hrs. Compressor	at \$ _____			
Trucking	\$ _____			
Pav't Patch	\$ _____			
	\$ _____			
	\$ _____			
	\$ _____			
	\$ _____			

C.R.N. THOMAS + THIRD
THIRD St. No. 104
 Name of Owner 10 Thomas
TAX ID # 309.11-9-9

Labor and Mat'l. Report 19 85

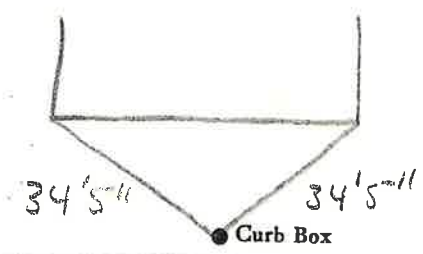

THIRD ST.
 Elev. of Main at tap _____
 6" Main
 Gate at • Gate at
26'6" to main

10 Thomas St • Curb Box
 TAP ON 3RD ST.

2 / 8