

### LABOR AND MATERIALS

Copper	} Connection		\$
Lead			
Curb	} Cock Valve T. S. & V.	in.	\$
Service box Old returned	} Short 3½ x 4½ Long 4½ x 5½		\$
Ft. 3/4 in.	} Copper <del>C.I.</del> <del>C.I.</del>	Pipe at	\$
Nipples	in. at		\$
Bushings	to in. at		\$
Red'g Inc'g	} Coupl'gs	to in. at	\$
Union	in. at		\$
Meter	in. at		\$
			\$
Compound Joints	at		\$
Maintenance Foreman			\$
Hrs. Water Maint. Man—1	at		\$
Hrs. Water Maint. Man—2	at		\$
Hrs. Garage Foreman	at		\$
Hrs. Labor—	at		\$
Hrs. Compressor	at		\$
			\$
Trucking			\$
Pav't Patch			\$
			\$
			\$
			\$
			\$

CRN. THOMAS + 3rd

FRONT FACES THOMAS NOW #  
St.  
THIRD ~~Pl.~~ Ave. No. 105


---

Name of Owner 8 THOMAS

TAX ID # 309.11-5-45

---

Labor and Mat'l. Report 1971

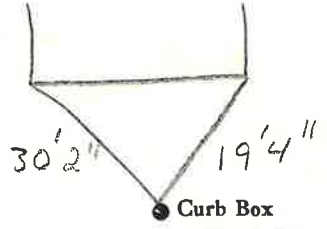

● Curb Box

---

Main	Elev. of Main at tap
Gate at ●	● Gate at

3/4" Copper

● Curb Box

TAP ON 3RD ST  
8 THOMAS ST