

LABOR AND MATERIALS

Copper	Connection	3/4	\$	2.87
Lead				
Curb	Cock Valve	3/4 in.	\$	3.62
	T. S. & V.			
Service box	Short 3/4 X 4 1/2			
Old returned	Long 4 1/2 X 5 1/2		\$	4.68
	Buff or Rdway			
9 Ft.	Copper	3/4 in.	Pipe at	2.88
	G. I.			
	C. I.			
Nipples	in. at		\$	
Bushings	to in. at		\$	
Red'g				
Inc'g	Coupl'gs to in. at		\$	
Union	in. at		\$	
Meter	in. at		\$	
Lead Joints	at		\$	
Compound Joints	at		\$	
Hrs. Water Maint. Man-1	at		\$	
2	Hrs. Water Maint. Man-2	1.02	\$	2.04
Hrs. Labor	at		\$	
Hrs. Labor	at		\$	
Hrs. Compressor	at		\$	
Compensation Ins.	at \$ per C		\$	1.14
Trucking			\$	2.00
Pay't Patch			\$	
Top 4 1/2 ft			\$	
O'head			\$	
			\$	18.13

44 - 1949


Thomas

St.
Pl.
Ave. No. 23

Name of Owner

Sullivan

Labor and Mat'l. Report June 6 1949

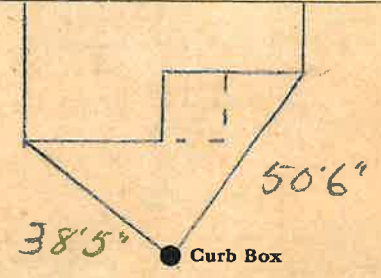

12 Main

Elev. of Main at tap 5

Gate at ●

● Gate at

3/4" Copper

9' to main

● Curb Box

TAX ID# 30941-1-78
Qbury

LSM-5C B 15-48