

LABOR AND MATERIALS

1	Copper	{ Connection	3/4"	\$	2.27
1	Lead	{			
1	Curb	{ Cock Valve	3/4" in.	\$	2.70
		{ F.S. & V.			
1	Service box	{ Short 3 1/2 x 4 1/2		\$	4.25
	Old returned	{ Long 4 1/2 x 5 1/2			
		{ Buff or Rdway			
9	Ft. 3/4 in.	{ Copper	Pipe at 25	\$	3.15
		{ G.I.			
		{ C.I.			
	Nipples	in. at		\$	
	Bushings	to in. at		\$	
	Red'g	{ Coupl'gs	to in. at	\$	
	Inc'g	{			
	Union	in. at		\$	
	Meter	in. at		\$	
	Lead Joints	at		\$	
	Compound Joints	at		\$	
	Hrs. Water Maint. Man-1	at		\$	
2	Hrs. Water Maint. Man-2	at 1.02		\$	2.04
2	Hrs. Labor	at 91		\$	1.82
	Hrs. Labor	at		\$	
	Hrs. Compressor	at		\$	
	Compensation Ins. at \$2.226 per C.			\$.09
	Trucking			\$	1.00
	Pay't Patch			\$	
	Tap by Moquin			\$	
				\$	
				\$	
	O'head			\$	
				\$	11.32

252-1120

25

Thomas


St. Corner of
Pl. Ave. No. 5th

Name of Owner

Sullivan

Labor and Mat'l. Report

Nov. 17 1950

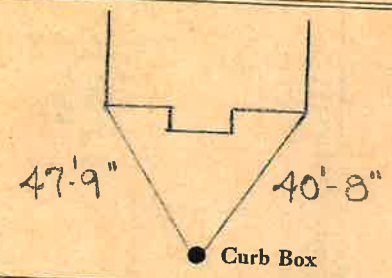

12" Main

Elev. of Main at tap 5'

Gate at ●

● Gate at

3/4" Copper

9' to main

● Curb Box

bury

TAX ID# 309.11-1-77