


LABOR AND MATERIALS

Copper } Connection _____	\$ _____
Lead } _____	\$ _____
Curb } Cock _____	\$ _____
} Valve _____	in. _____
} T. S. & V. _____	\$ _____
Service box { Short 3½ x 4½	\$ _____
Old returned { Long 4½ x 5½	
} Buff or Rdway _____	
14½" Ft. _____ in. { Copper	\$ _____
} G. I. _____	
} C. I. _____	
Nipples _____ in. at _____	\$ _____
Bushings _____ to _____ in. at _____	\$ _____
Red'g } Coupl'gs _____ to _____ in. at _____	\$ _____
Inc'g } _____	\$ _____
Union _____ in. at _____	\$ _____
Meter _____ in. at _____	\$ _____
Lead Joints at _____	\$ _____
Compound Joints at _____	\$ _____
Maintenance Foreman _____	\$ _____
Hrs. Water Maint. Man—1 at _____	\$ _____
Hrs. Water Maint. Man—2 at _____	\$ _____
Hrs. Garage Foreman _____ at _____	\$ _____
Hrs. Labor— _____ at _____	\$ _____
Hrs. Compressor at _____	\$ _____
Compensation Ins. at \$ _____ per C _____	\$ _____
Trucking _____	\$ _____
Pav't Patch _____	\$ _____
_____	\$ _____
_____	\$ _____
O'head _____	\$ _____
_____	\$ _____

St. Thomas
~~Pl.~~ Ave. No. 31

Name of Owner _____

Labor and Mat'l. Report 19

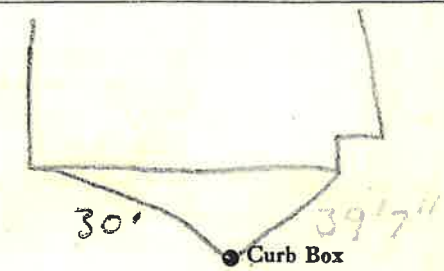

12' Main Elev. of Main at tap _____

Gate at • • Gate at _____
 14'4" to main

• Curb Box

O'bung

TAX ID# 309.15-1-27