

LABOR AND MATERIALS

Copper	} Connection	_____	\$ _____	
Lead				
Curb	} Cock } Valve } T. S. & V.	_____ in.	\$ _____	
		} Service box	} Short 3½ x 4½	} _____
23 Ft. 3/4 in.	{ Copper } G.I. } C.I.	} Pipe at _____	\$ _____	
Nipples	_____ in. at _____	\$ _____		
Bushings	_____ to _____ in. at _____	\$ _____		
Red'g Inc'g	} Coupl'gs. _____ to _____ in. at _____	\$ _____		
Union		_____ in. at _____	\$ _____	
Meter	_____ in. at _____	\$ _____		
Compound Joints	at _____	\$ _____		
Maintenance Foreman	_____	\$ _____		
Hrs. Water Maint. Man-1	at _____	\$ _____		
Hrs. Water Maint. Man-2	at _____	\$ _____		
Hrs. Garage Foreman	at _____	\$ _____		
Hrs. Labor	_____ at _____	\$ _____		
Hrs. Compressor	at _____	\$ _____		
Trucking	_____	\$ _____		
Pav't Patch	_____	\$ _____		
		\$ _____		
		\$ _____		
		\$ _____		
		\$ _____		

Blue House

Thomas


St. Pl. Ave. No. 32

Name of Owner

M. Lyford

Labor and Mat'l. Report

7 1987

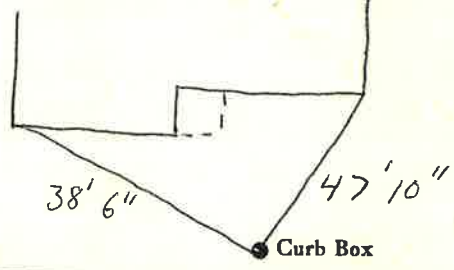

12" Main

Elev. of Main at tap \_\_\_\_\_

Gate at •

• Gate at

3/4" COPPER 23' to MAIN

• Curb Box

\* ~~House # 34 on house wing number~~

TAX ID # 309.11-14-25