

### LABOR AND MATERIALS


Copper } Connection _____	\$ _____
Lead } _____	\$ _____
Curb } Cock _____	in. _____ \$ _____
} Valve _____	
} T. S. & V. _____	
Service box { Short 3½ x 4½ _____	\$ _____
Old returned { Long 4½ x 5½ _____	
} Buff or Rdway _____	
Ft. _____ in. { Copper _____	Pipe at _____ \$ _____
} G. I. _____	
} C. I. _____	
Nipples _____ in. at _____	\$ _____
Bushings _____ to _____ in. at _____	\$ _____
Red'g } Coupl'gs _____ to _____ in. at _____	\$ _____
Inc'g } _____	
Union _____ in. at _____	\$ _____
Meter _____ in. at _____	\$ _____
Lead Joints at _____	\$ _____
Compound Joints at _____	\$ _____
Maintenance Foreman _____	\$ _____
Hrs. Water Maint. Man—1 at _____	\$ _____
Hrs. Water Maint. Man—2 at _____	\$ _____
Hrs. Garage Foreman _____ at _____	\$ _____
Hrs. Labor— _____ at _____	\$ _____
Hrs. Compressor at _____	\$ _____
Compensation Ins. at \$ _____ per C _____	\$ _____
Trucking _____	\$ _____
Pav't Patch _____	\$ _____
_____	\$ _____
_____	\$ _____
_____	\$ _____
O'head _____	\$ _____
_____	\$ _____

St. \_\_\_\_\_  
 -Pl. \_\_\_\_\_  
 Ave. No. 35

Rhodes

Name of Owner \_\_\_\_\_  
 \_\_\_\_\_

Labor and Mat'l. Report 19

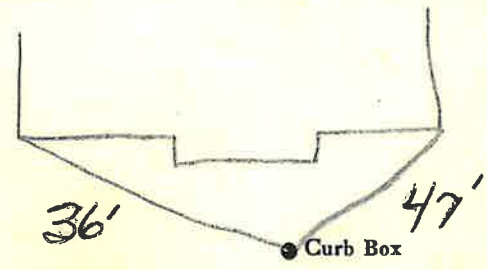

12" Main Elev. of Main at tap \_\_\_\_\_

Gate at ● ● Gate at \_\_\_\_\_

● Curb Box

Qbury

TAX ID# 309.15-1-25