

LABOR AND MATERIALS

Copper	}	Connection		\$	
Lead					
Curb	}	Cock	} in.	\$	
		Valve			
		T. S. & V.			
Service box	}	Short $3\frac{1}{2} \times 4\frac{1}{2}$		\$	
Old returned		Long $4\frac{1}{2} \times 5\frac{1}{2}$			
<u>26</u> Ft. <u>3/4</u> in.	}	Copper	} Pipe at	\$	
		G.I. C.I.			
Nipples	in. at			\$	
Bushings	to in. at			\$	
Red'g	}	Coupl'gs	to in. at	\$	
Inc'g					
Union	in. at			\$	
Meter	in. at			\$	
Compound Joints	at			\$	
Maintenance Foreman				\$	
Hrs. Water Maint. Man	1 at			\$	
Hrs. Water Maint. Man	2 at			\$	
Hrs. Garage Foreman	at			\$	
Hrs. Labor	at			\$	
Hrs. Compressor	at			\$	
Trucking				\$	
Pav't Patch				\$	
				\$	
				\$	
				\$	
				\$	


THOMAS

St.
~~Pl.~~
Aver No. 36

Name of Owner

Labor and Mat'l. Report

1992

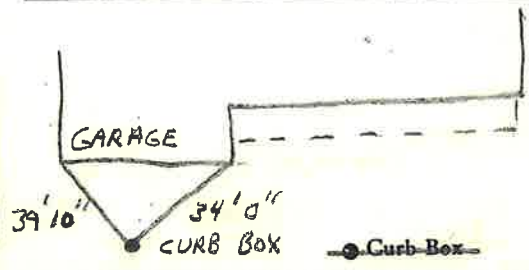

12" Main

Elev. of
Main at tap

Gate at ●

● Gate at

3/4 copper 26' to main

● Curb Box

TAX ID # 309.15-2-1.