

LABOR AND MATERIALS


1	Copper	Connection	3/4		\$ 2.87
	Lead				
1	Curb	Cock Valve	3/4	in.	\$ 3.62
		T. S. & V.			
1	Service box	Short 3/4 X 4 1/2			
	Old returned	Long 4 1/2 X 5 1/2			\$ 4.68
		Buff or Rdway			
17	Ft.	Copper		Pipe at	\$ 5.44
		G. I.			
		C. I.			
	Nipples	in.		at	\$
	Bushings	to		in. at	\$
	Red'g				
	Inc'g	Coupl'gs		to in. at	\$
	Union	in.		at	\$
	Meter	in.		at	\$
	Lead Joints	at			\$
	Compound Joints	at			\$
	Hrs. Water Maint. Man-1	at			\$
3	Hrs. Water Maint. Man-2	at	1.02		\$ 3.06
	Hrs. Labor	at			\$
	Hrs. Labor	at			\$
	Hrs. Compressor	at			\$
	Compensation Ins.	at \$		per C	\$ 0.07
	Trucking				\$ 2.00
	Pav't Patch				\$
	Tap by McGowan				\$
	O'head				\$
					\$ 21.74

22

St. _____
 Pl. _____
 Ave. No. 41

Name of Owner Ringer
Higgins

Labor and Mat'l. Report Dec 7 1948

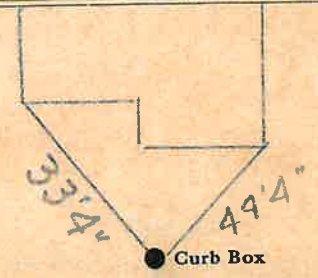

12" Main Elev. of Main at tap 5

Gate at ● ● Gate at

3/4 Copper 17' to main

● Curb Box

Albany Tax ID# 309.15-1-23