

LABOR AND MATERIALS

Copper	{ Connection	3/4			
1 Lead				\$	2.87
1 Curb	{ Cock Valve				
	{ T.S. & V.	3/4 in.		\$	3.62
1 Service box	{ Short 3 1/2 x 4 1/2				
Old returned	{ Long 4 1/2 x 5 1/2				
	{ Buff or Rdway			\$	4.68
15 Ft. 3/4 in.	{ Copper				
	{ C.I.				
		Pipe at	32	\$	4.80
Nipples	in. at			\$	
Bushings	to in. at			\$	
Red'g Inc'g	{ Coupl'gs	to	in. at	\$	
Union	in. at			\$	
Meter	in. at			\$	
Lead Joints at				\$	
Compound Joints at				\$	
Hrs. Water Maint. Man—1 at				\$	
2 Hrs. Water Maint. Man—2 at		1.02		\$	2.04
2 Hrs. Labor— at		91		\$	1.82
Hrs. Labor— at				\$	
Hrs. Compressor at				\$	
Compensation Ins. at \$ 2.18 per C.				\$.08
Trucking				\$	2.00
Pav't Patch				\$	
<i>Tap by 100 gals</i>					
O'head				\$	
				\$	21.91

112


St.
Pl.
Ave. No.

Thomas

Name of Owner

Sadley

Labor and Mat'l. Report *Oct 31* 19 *49*

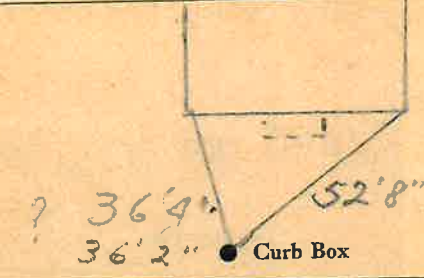

12 Main

Elev. of Main at tap *5*

Gate at ● Gate at

3/4" copper 15' to MAIN

● Curb Box