

LABOR AND MATERIALS


1	Copper Lead	{ Connection	3/4"	\$	2.29
1	Curb	{ Cock Valve P.S. & V.	3/4" in.	\$	2.70
1	Service box Old returned	{ Short 3 1/2 x 4 1/2 Long 4 1/2 x 5 1/2 Buff or Rdway		\$	4.25
9	Ft. 3/4 in.	{ Copper G.I. C.T.	Pipe at 35	\$	3.15
	Nipples	in. at		\$	
	Bushings	to in. at		\$	
	Red'g Inc'g	{ Coupl'gs to in. at		\$	
	Union	in. at		\$	
	Meter	in. at		\$	
	Lead Joints at			\$	
	Compound Joints at			\$	
	Hrs. Water Maint. Man-1	at		\$	
3	Hrs. Water Maint. Man-2	at 1.02		\$	3.06
3	Hrs. Labor	at 91		\$	273
	Hrs. Labor	at		\$	
	Hrs. Compressor at			\$	
	Compensation Ins. at \$	per C.		\$	13
	Trucking			\$	1.-
	Pav't Patch Outside			\$	
	Tap by Moquin			\$	
	O'head			\$	
				\$	19.31

BILLED BY QUEENSBURY

St. Thomas
~~Pl.~~ Ave. No. 3

Name of Owner Lemery

Labor and Mat'l. Report July 12 1950

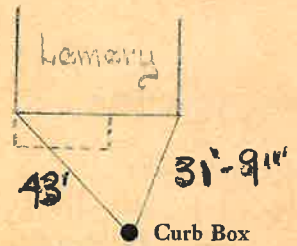

12" Main Elev. of Main at tap 5'

Gate at ● Gate at ●

3/4" Copper 9' to main

● Curb Box

TAX ID # 309.11-1-56