

### LABOR AND MATERIALS

1	Copper	{ Connection	<sup>3/4</sup>	\$	3.04
	Lead				
1	Curb	{ Cock Valve	<sup>3/4</sup> in.	\$	3.54
		{ T.S. & V.			
1	Service box	{ Short <sup>3 1/2</sup> x <sup>4 1/2</sup>		\$	4.70
	Old returned	{ Long <sup>4 1/2</sup> x <sup>5 1/2</sup>		\$	
		{ Buff or Rdway		\$	
11	Ft. <sup>3/4</sup> in.	{ Copper	Pipe at <sup>35</sup>	\$	3.85
		{ G.I.		\$	
		{ C.I.		\$	
	Nipples	in. at		\$	
	Bushings	to in. at		\$	
	Red'g	{ Coupl'gs to in. at		\$	
	Inc'g			\$	
	Union	in. at		\$	
	Meter	in. at		\$	
	Lead Joints at			\$	
	Compound Joints at			\$	
2	Hrs. Water Maint. Man-1 at		<sup>1.23</sup>	\$	2.46
	Hrs. Water Maint. Man-2 at			\$	
	Hrs. Labor	at		\$	
	Hrs. Labor	at		\$	
	Hrs. Compressor at			\$	
	Compensation Ins. at \$	per C.	<sup>07</sup>	\$	
	Trucking			\$	1.00
	Pav't Patch			\$	
				\$	
				\$	
				\$	
	O'head			\$	
	Tap by Miller			\$	18.66
	7-3-51				

101-1127


Thomas

St. 11  
-Pt. 11  
-Ave: No. 11

Name of Owner

Garrant

Labor and Mat'l. Report July 3 1951

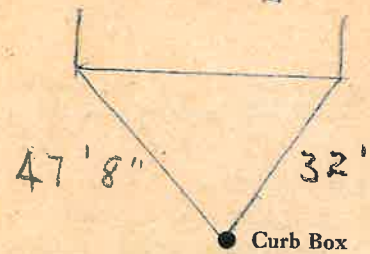

12" Main

Elev. of Main at tap 5'

Gate at ●

3/4" Copper

11' to main

● Curb Box

TAX ID # 309.11-1-68