

LABOR AND MATERIALS

1	Copper / Lead	Connection $\frac{3}{4}$			\$ 2.94
1	Curb	Cock Valve T. S. & V. $\frac{3}{4}$ in.			\$ 3.71
1	Service box	Short $3\frac{1}{2} \times 4\frac{1}{2}$			
	Old returned	Long $4\frac{1}{2} \times 5\frac{1}{2}$			
		Buff or Rdway			\$ 5.90
64	Ft. $\frac{3}{4}$ in.	Copper G.I. C.I.	Pipe at 30		\$ 5.10
	Nipples	in. at			\$
	Bushings	to in. at			\$
	Red'g				\$
	Inc'g	Coupl'gs to in. at			\$
	Union	in. at			\$
	Meter	in. at			\$
	Lead Joints at				\$
	Compound Joints at				\$
2	Hrs. Water Maint. Man-1	at 1.12			\$ 2.24
2	Hrs. Water Maint. Man-2	at 1.02			\$ 2.04
4	Hrs. Labor	at 91			\$ 3.64
	Hrs. Labor	at			\$
	Hrs. Compressor at				\$
	Compensation Ins. at \$	per C.			\$ 1.12
	Trucking				\$ 1.12
	Pav't Patch				\$
	Tax				\$
	Material				\$
	O'head	5ft from End of			\$
		Parment			\$ 26.74
		12' From Pole			

124

St.

Pl.


Ave. No. 19

Name of Owner

Byford

Labor and Mat'l. Report

Oct 26 1948

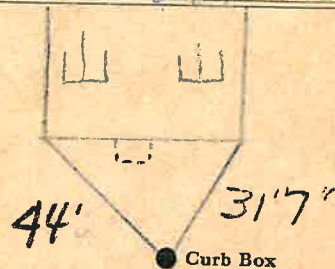

6 Main

Elev. of

Main at tap

5

Gate at

Gate at

at bury

TAX ID#

309.11-1-80

TAP IS ON THOMAS

~~This tap is on front of...~~