


Labor and Materials

1	Lead Connection	\$
1	Curb-Check	\$
1	Service Box (Short 3 1/2 x 4 1/2 Old returned Long 4 1/2 x 5 1/2 Buffalo)	\$
20	Ft. in. G. I. Pipe at	\$
	Nipples in. at	\$
	Bushings to in. at	\$
	Red'g Coup to in. at	\$
	Inc'g Coup to in. at	\$
	Union in. at	\$
	Meter in. at	\$
	Cu. Yds. Br. Stone at	\$
	Cu. Yds. Sand at	\$
	Bags Cement at	\$
	Paving Brick (Mack Red Asphalt) at	\$
7	Hrs. Foreman at	\$
18	Hrs. Common Labor at	\$
	Hrs. Mason at	\$
	Hrs. at	\$
	Hrs. at	\$
yes	Builders' Use of Water	\$
	Truck 1.00	\$
	at	\$
	at	\$
	at	\$
	at	\$
	Total	\$ 25.19

2123 Labor and Material Report

19

1" tap @ 16 & 18 Thomson Ave

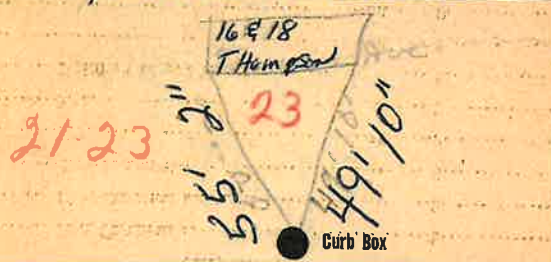

Broughton Co. Inc.

Main Elev. of Main at tap

Gate at 1" LEAD CONN. Gate at 25' to main

Curb Box TAX ID #302.16
1 1/4" gate 3-5
Valve
Takes Man 4
TURNS TO TURN ON + OFF