


LABOR AND MATERIALS

Copper	} Connection	_____	\$ _____		
Lead					
Curb	} Cock Valve T. S. & V. }	} _____ in.	\$ _____		
				} Service box	} { Short 3 1/2 x 4 1/2 Long 4 1/2 x 5 1/2 }
Ft. <u>3/4</u> in.	} Copper G. I. G. I. }	} Pipe at _____	\$ _____		
Nipples _____ in. at _____				\$ _____	
Bushings _____ to _____ in. at _____				\$ _____	
Red'g } Inc'g }	} Coupl'gs _____ to _____ in. at _____	\$ _____			
Union _____ in. at _____			\$ _____		
Meter _____ in. at _____	\$ _____				
_____	\$ _____				
Compound Joints at _____	\$ _____				
Maintenance Foreman _____	\$ _____				
Hrs. Water Maint. Man—1 at _____	\$ _____				
Hrs. Water Maint. Man—2 at _____	\$ _____				
Hrs. Garage Foreman _____ at _____	\$ _____				
Hrs. Labor _____ at _____	\$ _____				
Hrs. Compressor at _____	\$ _____				
_____	\$ _____				
Trucking _____	\$ _____				
Pav't Patch _____	\$ _____				
_____	\$ _____				
_____	\$ _____				
_____	\$ _____				
_____	\$ _____				

St. Thomson
 Pl. _____
 Ave. No. 24

Name of Owner _____
 TAX ID # 302.16-1-4

Labor and Mat'l. Report _____ 19 93

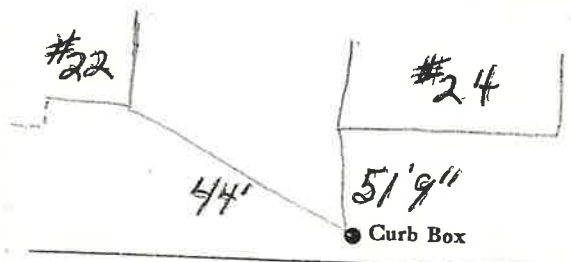

6" Main _____ Elev. of Main at tap _____
 Gate at • _____ Gate at _____

3/4" Copper

• Curb Box