


**Labor and Materials**

Copper	Connection	3	\$ 2.70
Lead		2	
Curb	Cock Valve	3	\$ 1.00
	T. S. & V.	1	
Service Box	Short 3/4x4 1/2		\$ 1.20
Old returned	Long 1 1/2x2 1/2		
	Buff on Rdway		
26 Ft.	Copper Galv. Iron Pipe at	3/4	\$ 57.2
	Cast Iron	1/4	
Nipples	in. at		\$
Bushings	to in. at		\$
Red'g Inc'g	Couplings to in. at		\$
Union	in. at		\$
Meter	in. at		\$
Lbs. Br. Stone	at		\$
Lbs. Sand	at		\$
Bags Cement	at		\$
Paving Brick	Mack Red Asphalt at		\$
Lead Joints	at		\$
Leadite Joints	at		\$
4 Hrs.	Foreman at		\$ 2.50
7 Hrs.	Common Labor at		\$ 2.84
Hrs.	Common Labor at		\$
Hrs.	Mason at		\$
Hrs.	Mason's Helper at		\$
Hrs.	Compressor at		\$
Compensation Ins			\$ 14
Trucking			\$ 10.0
Builders' Use of Water			\$

Total \$ 17.70

73-109 25- Sept 5 1928

Labor and Material Report  
 177 Harrison Ave New house

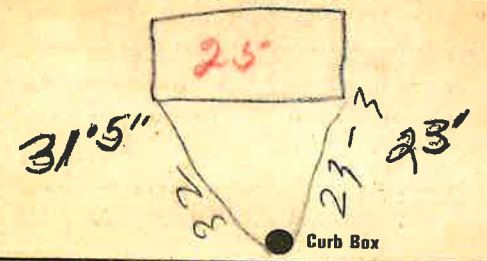

4 Main Eley of Main at tap 5  
 Gate at 3/4" Copper Gate at 26' to MAIN

● Curb Box

New House

TAX ID # 302.16-3-4