

LABOR AND MATERIALS

1	Copper Lead	Connection	3/4"	\$	3.08
1	Curb	Cock Valve T.S. & V.	3/4" in.	\$	3.89
1	Service box Old returned	Short 3 1/2 x 4 1/2 Long 4 1/2 x 5 1/2 Buff or Rdway		\$	1.32
9	Ft. 3/4 in.	Copper C.I.	Pipe at 45	\$	40.5
	Nipples	in. at		\$	
	Bushings	to in. at		\$	
	Red'g Inc'g	Coupl'gs to in. at		\$	
	Union	in. at		\$	
	Meter	in. at		\$	
	Lead Joints at			\$	
	Compound Joints at			\$	
	Maintenance Foreman			\$	4.92
	Hrs. Water Maint. Man-1 at			\$	
8	Hrs. Water Maint. Man-2 at	1.613		\$	12.90
1 1/2	Hrs. Garage Foreman at	2.033		\$	3.05
10	Hrs. Labor at	1.30		\$	13.00
	Hrs. Compressor at			\$	
	Compensation Ins. at \$	5.686 per C		\$	1.65
	Trucking			\$	1.50
	Pav't Patch			\$	7.20
	Tap by Gifford & Co.				\$
	11-9-56				\$
	O'head			\$	
				\$	55.64

48

Thomson


St.
El.
Ave. No. 28

Name of Owner

R. Mound

Labor and Mat'l. Report

Nov. 9 1956

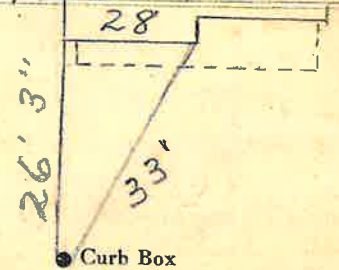

6" Main

Elev. of Main at tap 4'

Gate at •

• Gate at

3/4" copper 9' to main

• Curb Box

TAX ID # 302.16-1-6