

THOMSON


St. Ave. No. 28 1/2

Name of Owner

TAX ID # 302.16-1-7

Labor and Mat'l. Report

1994

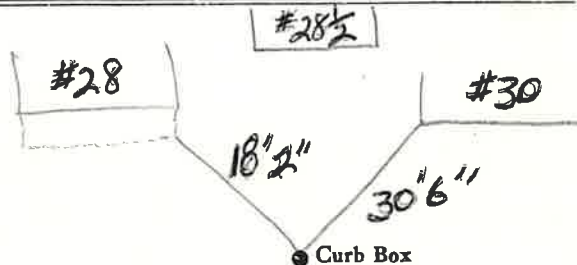

Main

Elev. of Main at tap

Gate at ●

● Gate at

3/4" Copper

9' to main

● Curb Box

LSM-5C-6-1-67

136 34 28 1/2
Labor and Material Report

Nov 15 1934

27 Thomson Ave



6 Main

Elev. of Main at tap 5

Gate at ●

● Gate at

● Curb Box

old shut off at main
This Tap for 28 Rear
THOMSON AVE.

Measured from
28 THOMSON
Ave.

VM

LABOR AND MATERIALS

Copper	} Connection	_____	\$ _____	
Lead				
Curb	} Cock Valve T. S. & V.	_____ in.	\$ _____	
Service box		} Short 3½ x 4½ Long 4½ x 5½	_____	\$ _____
Old returned				
Ft. ^{3/4} in.	} Copper C.I. C.I.	Pipe at _____	\$ _____	
Nipples		_____ in. at _____	\$ _____	
Bushings	_____ to _____ in. at _____	\$ _____		
Red'g Inc'g	} Coupl'gs	_____ to _____ in. at _____	\$ _____	
Union		_____ in. at _____	\$ _____	
Meter	_____ in. at _____	\$ _____		
Compound Joints	at _____	\$ _____		
Maintenance Foreman	_____	\$ _____		
Hrs. Water Maint. Man—1	at _____	\$ _____		
Hrs. Water Maint. Man—2	at _____	\$ _____		
Hrs. Garage Foreman	at _____	\$ _____		
Hrs. Labor	at _____	\$ _____		
Hrs. Compressor	at _____	\$ _____		
Trucking	_____	\$ _____		
Pav't Patch	_____	\$ _____		
		\$ _____		
		\$ _____		
Labor and Materials

Copper	} Connection	_____	\$ 1.50	
Lead				
Curb	} Cock Valve T.S.&V.	_____ in	\$ 1.70	
Service Box		} Short 3½ x 4½ Long 4½ x 5½	_____	\$ 1.44
Old returned			_____ Buff. or R.Way	
6 Ft. _____ in.	} Copper Galv. Iron Cast Iron	Pipe at _____	\$ 1.71	
Nipples		_____ in. at _____	\$ _____	
Bushings	_____ to _____ in. at _____	\$ _____		
Red'g Inc'g	} Couplings	_____ to _____ in. at _____	\$ _____	
Union		_____ in. at _____	\$ _____	
Meter	_____ in. at _____	\$ _____		
Lbs. Br. Stone	at _____	\$ _____		
Lbs. Sand	at _____	\$ _____		
Bags Cement	at _____	\$ _____		
Paving Brick	} Mack Red Asphalt	at _____	\$ _____	
Lead Joints		at _____	\$ _____	
Leadite Joints	at _____	\$ _____		
7 Hrs. Foreman	at 62.15	\$ 1.25		
8 Hrs. Common Labor	at 4.5	\$ 3.60		
Hrs. Common Labor	at _____	\$ _____		
Hrs. Mason	at _____	\$ _____		
Hrs. Masons Helper	at _____	\$ _____		
Hrs. Compressor	at _____	\$ _____		
Compensation Ins	_____	\$ 0.17		
Trucking	_____	\$ 1.15		
Builders Use of Water	Pav. Patch	\$ 5.00		

Total \$ 17.37