


Labor and Materials

1	Copper	Connection	3	\$ 1.48
1	Lead		1	
1	Curb	Cock Valve T.S.&V.	1	\$ 1.79
1	Service Box	Short 3 1/2 x 4 1/2		\$ 1.30
1	Old returned	Long 4 1/2 x 5 1/2		
		Buff. or Railway		
1/2	Ft.	Copper	2	\$ 2.16
		Galv. Iron		
		Cast Iron		
		Pipe at	4	
		Nipples		\$
		Bushings		\$
		Red'g Inc'g		\$
		Couplings		\$
		Union		\$
		Meter		\$
		Lbs. Br. Stone		\$
		Lbs. Sand		\$
		Bags Cement		\$
		Paving Brick		\$
		Lead Joints		\$
		Leadite Joints		\$
7	Hrs.	Foreman		\$ 1.25
7	Hrs.	Common Labor at Tapper		\$ 2.00
6	Hrs.	Common Labor at		\$ 2.70
		Hrs. Mason		\$
		Hrs. Masons Helper		\$
		Hrs. Compressor		\$
		Compensation Ins		\$ 1.19
		Trucking		\$ 1.00
		Builders Use of Water Patch		\$ 5.00

Total \$ 78.87

532-120 33  
 Labor and Material Report Nov 26 1932

29 THOMSON AVE

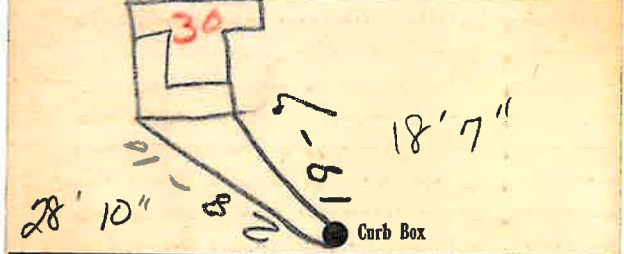

6 Main Elev of Main at tap 5

Gate at 3/4 copper 12' to MAIN Gate at

● Curb Box

old Tap shut off at Main

TAX ID# 302:16-1-8

OK G.H.O.