


LABOR AND MATERIALS

1	Copper	} Connection	3/4"	\$	
	Lead				
1	Curb	} Cock Valve T. S. & V.	3/4" Oriseal.	\$	
1	Service box	} Short 3 1/2 x 4 1/2	4' x 5'	\$	
	Old returned				Long 4 1/2 x 5 1/2
					Buff or Rdway
11	Ft. 3/4 in.	} Copper	Pipe at	\$	
					G.I.
					C.I.
	Nipples	in. at	\$		
	Bushings	to in. at	\$		
	Red'g } Inc'g	Coupl'gs to in. at	\$		
	Union	in. at	\$		
	Meter	in. at	\$		
	Lead Joints	at	\$		
	Compound Joints	at	\$		
	Maintenance Foreman		\$		
	Hrs. Water Maint. Man-1	at	\$		
	Hrs. Water Maint. Man-2	at	\$		
	Hrs. Garage Foreman	at	\$		
	Hrs. Labor	at	\$		
	Hrs. Compressor	at	\$		
	Compensation Ins. at \$	per C	\$		
	Trucking		\$		
	Pav't Patch		\$		
	Top by Seymour Plc		\$		
			\$		
		7-26-71.	\$		
	O'head		\$		
			\$		

110-4-2-9

Thomson
 -St. Pl. Ave. No. 34

Name of Owner
 Glendeen Bigelow

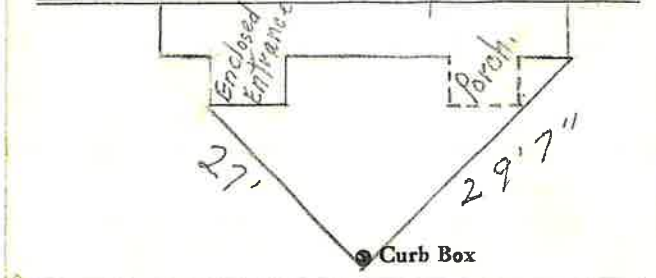

6" Main Elev. of Main at tap 5'

Gate at • Gate at
 3/4" Copper 11' to main

• Curb Box

TAX ID # 302.16-1-10