

LABOR AND MATERIALS


1 Copper Lead } Connection 3/4" \$ \_\_\_\_\_  
 1 Curb } Cock Valve } 3/4 in. ORISEAL \$ \_\_\_\_\_  
 T.S. & V. }  
 1 Service box } Short 3 1/2 x 4 1/2 } W/ ORISEAL \$ \_\_\_\_\_  
 Old returned } Long 4 1/2 x 5 1/2 } CAP \$ \_\_\_\_\_  
 Buff or Rdway }  
 25 Ft. 3/4 in. } Copper } Pipe at \_\_\_\_\_ \$ \_\_\_\_\_  
 C.I. }  
 C.I. }  
 Nipples \_\_\_\_\_ in. at \_\_\_\_\_ \$ \_\_\_\_\_  
 Bushings \_\_\_\_\_ to \_\_\_\_\_ in. at \_\_\_\_\_ \$ \_\_\_\_\_  
 Red'g } Coupl'gs \_\_\_\_\_ to \_\_\_\_\_ in. at \_\_\_\_\_ \$ \_\_\_\_\_  
 Inc'g }  
 Union \_\_\_\_\_ in. at \_\_\_\_\_ \$ \_\_\_\_\_  
 Meter \_\_\_\_\_ in. at \_\_\_\_\_ \$ \_\_\_\_\_  
 Lead Joints at \_\_\_\_\_ \$ \_\_\_\_\_  
 Compound Joints at \_\_\_\_\_ \$ \_\_\_\_\_  
 Maintenance Foreman \_\_\_\_\_ \$ \_\_\_\_\_  
 Hrs. Water Maint. Man-1 at \_\_\_\_\_ \$ \_\_\_\_\_  
 Hrs. Water Maint. Man-2 at \_\_\_\_\_ \$ \_\_\_\_\_  
 Hrs. Garage Foreman \_\_\_\_\_ at \_\_\_\_\_ \$ \_\_\_\_\_  
 Hrs. Labor \_\_\_\_\_ at \_\_\_\_\_ \$ \_\_\_\_\_  
 Hrs. Compressor at \_\_\_\_\_ \$ \_\_\_\_\_  
 Compensation Ins. at \$ \_\_\_\_\_ per C \_\_\_\_\_ \$ \_\_\_\_\_  
 Trucking \_\_\_\_\_ \$ \_\_\_\_\_  
 Pav't Patch \_\_\_\_\_ \$ \_\_\_\_\_  
 TAP MADE BY DONAVAN \$ \_\_\_\_\_  
LCO \$ \_\_\_\_\_  
 O'head NOV 18-1971 \$ \_\_\_\_\_  
 \$ \_\_\_\_\_

Curb Box in Sidewalk

St. THOMSON ~~Pl.~~ Ave. No. 35

Name of Owner MARTIN

Labor and Mat'l. Report NOV 18 1971

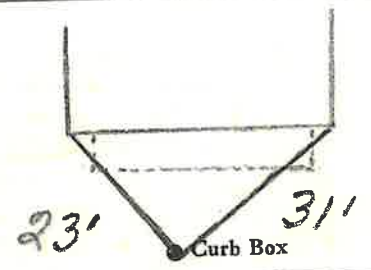

6" Main Elev. of Main at tap 5'

Gate at • Gate at

3/4" Copper 25' to main

• Curb Box

TAX ID # 302.16-4-15