


LABOR AND MATERIALS

1 Copper } Connection  $\frac{3}{4}$ " \$  
 Lead }  
 1 Curb } Cook }  $\frac{3}{4}$ " in. (M+R 211) \$  
 Valve } (ORISS 41)  
 P.S. & V. }  
 1 Service box { Short  $3\frac{1}{2}$  x  $4\frac{1}{2}$  } \$  
 Old returned { Long  $4\frac{1}{2}$  x  $5\frac{1}{2}$  } \$  
 { Buff or Rdway } \$  
 23  $\frac{3}{4}$  Ft. } { Copper } Pipe at \$  
 in. } Gal. }  
 Nipples in. at \$  
 Bushings to in. at \$  
 Red'g } Coupl'gs to in. at \$  
 Inc'g }  
 Union in. at \$  
 Meter in. at \$  
 Lead Joints at \$  
 Compound Joints at \$  
 Maintenance Foreman \$  
 Hrs. Water Maint. Man-1 at \$  
 Hrs. Water Maint. Man-2 at \$  
 Hrs. Garage Foreman at \$  
 Hrs. Labor at \$  
 Hrs. Compressor at \$  
 Compensation Ins. at \$ per C \$  
 Trucking \$  
 Pav't Patch \$  
 Tap Made By Giffords & Co \$  
 July-18-1973 \$  
 O'head \$

THOMSON Ser. No. 37  
 Ave. No. 37

Name of Owner  
 Preston HARRINGTON

Labor and Mat'l. Report July 18 1973

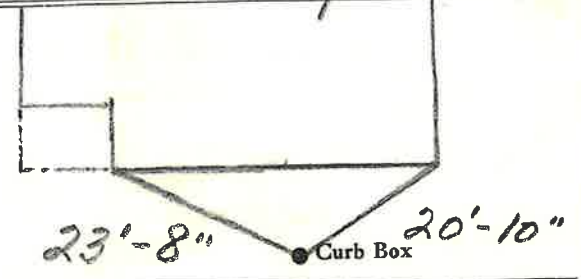

6" Main Elev. of Main at tap 5'

Gate at • Gate at  
 $\frac{3}{4}$ " copper 23' to main  
 • Curb Box

TAX ID # 302.16-4-14