


LABOR AND MATERIALS

1	Copper	Connection	3/4"	\$
1	Curb	Cock Valve	3/4" in. (ORIGINAL)	\$
1	Service box	Short 3 1/2" - 4 1/2"	used	\$
Old returned	Long 4 1/2" x 5 1/2"	SAME BOX		
9	Ft. 3/4 in.	Copper	Pipe at	\$
	Nipples	in. at		\$
	Bushings	to in. at		\$
	Red'g			\$
	Ine'g	Coupl'gs to in. at		\$
	Union	in. at		\$
	Meter	in. at		\$
	Lead Joints	at		\$
	Compound Joints	at		\$
	Maintenance Foreman			\$
	Hrs. Water Maint. Man-1	at		\$
	Hrs. Water Maint. Man-2	at		\$
	Hrs. Garage Foreman	at		\$
	Hrs. Labor	at		\$
	Hrs. Compressor	at		\$
	Compensation Ins.	at \$ per C		\$
	Trucking			\$
	Pav't Patch			\$
	Tap made by Peck & Co			\$
	O'head	NOV 28-1972		\$

St. Thomson Ave. No. 10

Name of Owner Augustus Lesser

Labor and Mat'l. Report NOV 28 1972

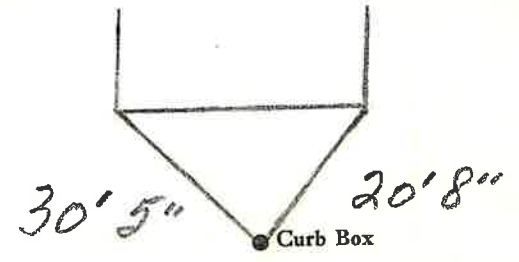

6" Main Elev. of Main at tap 5 1/2'

Gate at • Gate at •
 3/4" Copper 9' to main
 • Curb Box

TAX ID # 302.15-8-9