

LABOR AND MATERIALS

Copper	} Connection	_____	\$ _____			
Lead						
Curb	} Cock Valve T. S. & V.	} _____ in.	\$ _____			
				Service box	} Short 3 1/2 x 4 1/2	} _____
Ft. 1 1/2 in.	} Copper G.I. G.I.	} Pipe at	\$ _____			
Nipples _____ in.			at _____	\$ _____		
Bushings _____ to _____ in.		at _____	\$ _____			
Red'g } Inc'g }	} Coupl'gs.	} to _____ in.	at _____ \$ _____			
Union _____ in.				at _____ \$ _____		
Meter _____ in.		at _____	\$ _____			
_____			\$ _____			
Compound Joints		at _____	\$ _____			
Maintenance Foreman			\$ _____			
Hrs. Water Maint. Man—1		at _____	\$ _____			
Hrs. Water Maint. Man—2		at _____	\$ _____			
Hrs. Garage Foreman		at _____	\$ _____			
Hrs. Labor—		at _____	\$ _____			
Hrs. Compressor		at _____	\$ _____			
_____			\$ _____			
Trucking			\$ _____			
Pav't Patch			\$ _____			
_____			\$ _____			
_____			\$ _____			
_____			\$ _____			
_____			\$ _____			

THOMSON


St. _____
Pt. _____
Ave. No. 11-13

Name of Owner

TAX ID # 302.16-2-3

Labor and Mat'l. Report

19 90

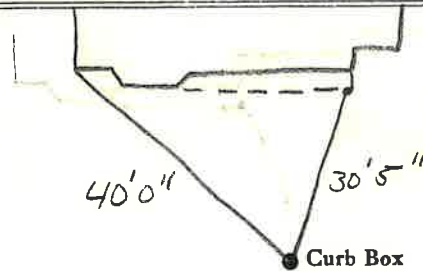

_____ Main	Elev. of Main at tap _____
Gate at ●	● Gate at _____
1 1/2" Copper	
	● Curb Box

LSM-5C-6-1-67