

Labor and Materials

Copper } Connection.....	3	\$ 3.20
Lead }		
Curb } Cock Valve }	3	\$ 1.00
} T. S. & V. }	3	
Service Box }		\$ 14.00
Old returned }		
5 Ft. 3/4" in. } Copper } Pipe at.....		\$ 1.10
} Galv. Iron }		
} Cast Iron }		
Nipples..... in. at.....		\$
Bushings..... to..... in. at.....		\$
Red'g } Couplings..... to..... in. at.....		\$
Inc'g }		
Union..... in. at.....		\$
Meter..... in. at.....		\$
Lbs. Br. Stone at.....		\$
Lbs. Sand at.....		\$
Bags Cement at.....		\$
Paving Brick } Mack } at.....		\$
} Red }		
} Asphalt }		
Lead Joints at.....		\$
Leadite Joints at.....		\$
3 Hrs. Foreman at.....		\$ 18.8
1 1/2 Hrs. Common Labor at.....		\$ 4.88
Hrs. Common Labor at.....		\$
Hrs. Mason at.....		\$
Hrs. Mason's Helper at.....		\$
Hrs. Compressor at.....		\$
Compensation Ins.....		\$ 18
Trucking.....		\$ 100
Builders' Use of Water.....		\$


Total \$176.4

28-51 16

Labor and Material Report

June 1 1928

13 Thompson Ave

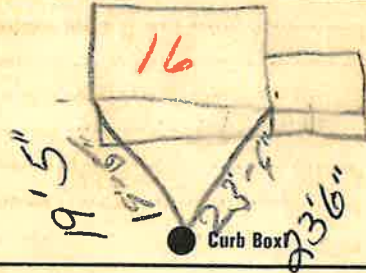

Main

Elev. of Main at tap 5 1/2

Gate at 3/4" Copper 5' to main Gate at

● Curb Box

TAX ID # 302.15-8-11