

LABOR AND MATERIALS

1/2" Copper	Connection	\$
Lead		
1 Curb	Cook Valve } 3/4 in. Oriseal,	\$
	T.S. & V. }	
Same	Service box { Short 3 1/2 x 4 1/2	
	Old returned { Long 4 1/2 x 5 1/2	\$
	Buff or Rdway }	
8' Ft. 3/4 in.	{ Copper } Pipe at	\$
	{ G.I. }	
	{ C.I. }	
1 Nipples 3/4 in.	at Galv.	\$
1 Bushings 3/4 in.	to Adapter	\$
1 Red'g. Coupl'gs	Galv. 3/4 to 1 in.	\$
Union	in. at	\$
Meter	in. at	\$
Lead Joints	at	\$
Compound Joints	at	\$
Maintenance Foreman		\$
Hrs. Water Maint. Man-1	at	\$
Hrs. Water Maint. Man-2	at	\$
Hrs. Garage Foreman	at	\$
Hrs. Labor	at	\$
Hrs. Compressor	at	\$
Compensation Ins.	at \$ per C.	\$
Trucking		\$
Pav't Patch	B.T.	\$
	Tap by Giesford + C.	\$
	5-5-65,	\$
O'head		\$

THOMSON


St. Ave. No. 17

Name of Owner TAX ID# 302.16.3-7

KIRCHOF

Labor and Mat'l. Report

MAY 5 1965

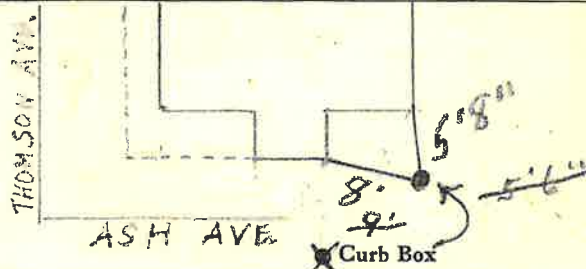

2" Main GALV.

Elev. of Main at tap 4'

Gate at ●

● Gate at

Tap on Ash Ave.

● Curb Box

ORIGINAL TAP OCT. 6 1924

USED SAME CURB BOX

" " LEAD & CORP. STOP

ORISEAL 8' to MAIN

9' - 5.6