

Labor and Materials

Copper	Connection.....	3	\$ 1.33
Lead		5	
Curb	Cock Valve	3	\$ 1.58
	in	4	
Service Box	Short 3/2 x 1 1/2		\$ 1.36
Old returned	Long 4 1/2 x 5 1/2		
	Both or Edway		
7 Ft.	Copper Galv. Iron Pipe at	3	\$ .67
	Galv. Iron	4	
Nipples	in. at		\$
Bushings	to in. at		\$
Red'g Inc'g	Couplings.....to.....in.at		\$
Union	in. at		\$
Meter	in. at		\$
Lbs. Br. Stone	at		\$
Lbs. Sand	at		\$
Bags Cement	at		\$
Paving Brick	Mack Red Asphalt } at		\$
Lead Joints	at		\$
Leadite Joints	at		\$
10 Hrs. Foreman	at	1	\$ 88
8 Hrs. Common Labor	at	4	\$ 360
Hrs. Mason	at		\$
Hrs. Masons Helper	at		\$
Hrs. Compressor	at		\$
Compensation Ins		29	\$
Trucking		1	\$
Builders Use of Water	Patch	5	\$

Total \$20.69


33-36

20

Labor and Material Report

June 21 1933

17 Thomson Ave

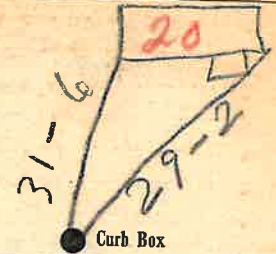

Main

Elev. of Main at tap 4 1/2

Gate at ●

● Gate at

3/4" Copper ● Curb Box 7' to main

old Tap shut of at drain

TAX ID# 302.16-1-2

*[Handwritten signature]*

*[Handwritten mark]*