

LABOR AND MATERIALS


1 Copper } Connection  $\frac{3}{4}$ " \$ \_\_\_\_\_  
 Lead }  
 1 Curb } Cock }  $\frac{3}{4}$ " in. \$ \_\_\_\_\_  
 Valve }  
 T.S. & V. }  
 1 Service box } Short  $3\frac{1}{2}$  x  $4\frac{1}{2}$  }  
 Old returned } Long  $4\frac{1}{2}$  x  $5\frac{1}{2}$  } \$ \_\_\_\_\_  
 Buff or Rdway }  
 12 Ft.  $\frac{3}{4}$  in. } Copper } Pipe at \$ \_\_\_\_\_  
 } G.I. }  
 } C.I. }  
 Nipples in. at \$ \_\_\_\_\_  
 Bushings to in. at \$ \_\_\_\_\_  
 Red'g }  
 Inc'g } Coupl'gs to in. at \$ \_\_\_\_\_  
 Union in. at \$ \_\_\_\_\_  
 Meter in. at \$ \_\_\_\_\_  
 Lead Joints at \$ \_\_\_\_\_  
 Compound Joints at \$ \_\_\_\_\_  
 Maintenance Foreman \$ \_\_\_\_\_  
 Hrs. Water Maint. Man—1 at \$ \_\_\_\_\_  
 Hrs. Water Maint. Man—2 at \$ \_\_\_\_\_  
 Hrs. Garage Foreman at \$ \_\_\_\_\_  
 Hrs. Labor— at \$ \_\_\_\_\_  
 Hrs. Compressor at \$ \_\_\_\_\_  
 Compensation Ins. at \$ \_\_\_\_\_ per C \$ \_\_\_\_\_  
 Trucking \$ \_\_\_\_\_  
 Pav't Patch \$ \_\_\_\_\_  
 \$ \_\_\_\_\_  
 Top Aug 1, 1978 \$ \_\_\_\_\_  
 Baerlein + Co. \$ \_\_\_\_\_  
 O'head \$ \_\_\_\_\_  
 \$ \_\_\_\_\_

Thornberry Dr St. No. 2  
 Pl. Ave. No. 2

Name of Owner

Ben Graves

Labor and Mat'l. Report Aug 1, 1978

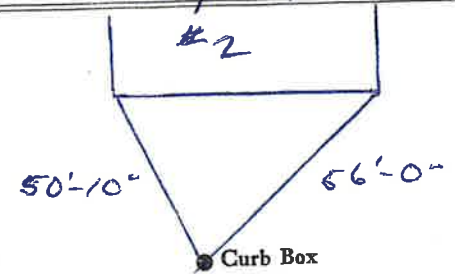

8" Main

Elev. of Main at tap 6'

Gate at •

• Gate at

$\frac{3}{4}$ " Copper 12' to main

• Curb Box

TAX ID # 309.15-8-53