

LABOR AND MATERIALS

1 Copper Connection $3/4"$ \$
 1 Curb Cock Valve $3/4"$ in. (MARK II ORIGINAL) \$
 1 Service box Short $3\frac{1}{2} \times 4\frac{1}{2}$ }
 Old returned Long $4\frac{1}{2} \times 5\frac{1}{2}$ } \$
 35 $3/4"$ in. Copper Pipe at \$
 Nipples in. at \$
 Bushings to in. at \$
 Red'g } Coupl'gs to in. at \$
 Inc'g }
 Union in. at \$
 Meter in. at \$
 Lead Joints at \$
 Compound Joints at \$
 Maintenance Foreman \$
 Hrs. Water Maint. Man-1 at \$
 Hrs. Water Maint. Man-2 at \$
 Hrs. Garage Foreman at \$
 Hrs. Labor at \$
 Hrs. Compressor at \$
 Compensation Ins. at \$ per C \$
 Trucking \$
 Pav't Patch \$
 TAP MADE BY GIFFORD & CO \$
 JAN-12-1973 \$
 O'head \$
 \$

Thompson


St. PT. No. 12
 WINDY HILL Rd

Name of Owner

JAMES BUTLER

Labor and Mat'l. Report

JAN 12 1973

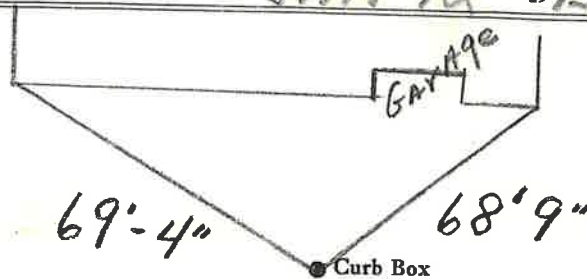

8" Main

Elev. of Main at tap 4'

Gate at ●

● Gate at

$3/4"$ Copper 35' to main

● Curb Box

TAX ID # 309.15-7-3