


LABOR AND MATERIALS

1	Copper	Connection	3/4"	\$
1	Curb	Cock Valve	3/4 in. <i>ORISPA1</i>	\$
1	Service box	{ Short 3 1/2 x 4 1/2 Long 4 1/2 x 5 1/2 Buff. or Rdway }		\$
Old returned				
7	Ft. 3/4 in.	Copper	Pipe at	\$
	Nipples	in. at		\$
	Bushings	to in. at		\$
	Red'g Inc'g	Coupl'gs. to in. at		\$
	Union	in. at		\$
	Meter	in. at		\$
	Lead Joints at			\$
	Compound Joints at			\$
	Maintenance Foreman			\$
	Hrs. Water Maint. Man-1 at			\$
	Hrs. Water Maint. Man-2 at			\$
	Hrs. Garage Foreman at			\$
	Hrs. Labor at			\$
	Hrs. Compressor at			\$
	Compensation Ins. at \$	per C		\$
	Trucking			\$
	Pav't Patch			\$
	<i>Tap made By St. John &amp; Co</i>			\$
	<i>Aug-22-1975</i>			\$
	O'head			\$

Thronberry Dr. Se. Pl. Ave. No. 18

Name of Owner *Alfred EIKS*

Labor and Mat'l. Report *Aug. 22 1975*

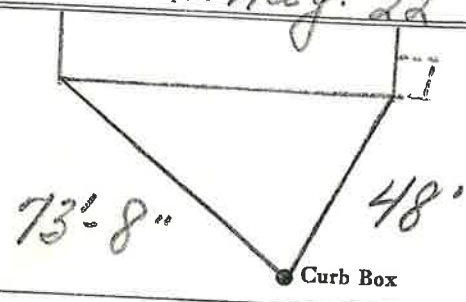

8" Main Elev. of Main at tap *5 1/2'*

Gate at • Gate at •  
*3/4" Copper 7' to main*  
 • Curb Box

TAX ID # 309.15-8-59