

LABOR AND MATERIALS


Copper	} Connection	_____	\$ _____	
Lead				
Curb	} Cock Valve T. S. & V. }	_____ in.	\$ _____	
Service box		} Short 3½ x 4½ Long 4½ x 5½ }	_____	\$ _____
Old returned				
31 1/2" Ft. 3/4 in.	} Copper G.I. G.I. }	Pipe at _____	\$ _____	
Nipples		_____ in. at _____	\$ _____	
Bushings		_____ to _____ in. at _____	\$ _____	
Red'g Inc'g	} Coupl'gs	_____ to _____ in. at _____	\$ _____	
Union		_____ in. at _____	\$ _____	
Meter	_____ in. at _____	\$ _____		
Compound Joints	at _____	\$ _____		
Maintenance Foreman	_____	\$ _____		
Hrs. Water Maint. Man-1	at _____	\$ _____		
Hrs. Water Maint. Man-2	at _____	\$ _____		
Hrs. Garage Foreman	at _____	\$ _____		
Hrs. Labor	at _____	\$ _____		
Hrs. Compressor	at _____	\$ _____		
Trucking	_____	\$ _____		
Pav't Patch	_____	\$ _____		
		\$ _____		
		\$ _____		
		\$ _____		
		\$ _____		

Du
St.
Pt.
Ave. No. 19

Rhombeny

Name of Owner _____
TAX ID # 309.15-7-1

Labor and Mat'l. Report 19 90

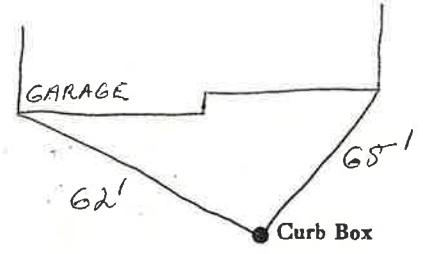

_____ Main	Elev. of Main at tap _____
Gate at ●	● Gate at

3/4" Copper 31' 2" to main

● Curb Box