


LABOR AND MATERIALS

1	Copper Lead	Connection	$\frac{3}{4}$ "	\$
1	Curb	Cock Valve T.S. & V.	$\frac{3}{4}$ in. Oriseal	\$
1	Service box	Short $3\frac{1}{2}$ x $4\frac{1}{2}$		
	Old returned	Long $4\frac{1}{2}$ x $5\frac{1}{2}$		
		Buff or Rdway		\$
8	Ft. $\frac{3}{4}$ in.	Copper G.I. Pipe at		\$
	Nipples	in. at		\$
	Bushings	to in. at		\$
	Red'g Inc'g	Coupl'gs to in. at		\$
	Union	in. at		\$
	Meter	in. at		\$
	Lead Joints	at		\$
	Compound Joints	at		\$
	Maintenance Foreman			\$
	Hrs. Water Maint. Man-1	at		\$
	Hrs. Water Maint. Man-2	at		\$
	Hrs. Garage Foreman	at		\$
	Hrs. Labor	at		\$
	Hrs. Compressor	at		\$
	Compensation Ins.	at \$ per C		\$
	Trucking			\$
	Pav't Patch			\$
	Tap by Gifford & Co			\$
	1-7-66			\$
	O'head			\$

Dr. Thornberry  
 Sr. Ave. No. 20  
 Pl.

Name of Owner  
Mr. John E. Hughes  
Donald G. Groves

Labor and Mat'l. Report Jan. 7 1966

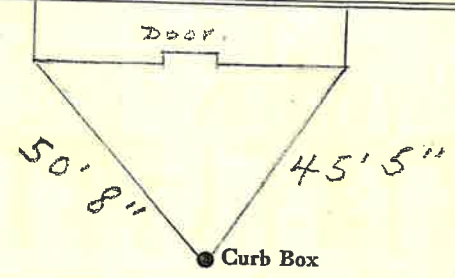

8" Main Elev. of Main at tap 4'

Gate at • Gate at  
 $\frac{3}{4}$  Copper 8' to main

• Curb Box

TAX ID # 309.15-8-60